


T. 35 S., R. 3 W., W. M.

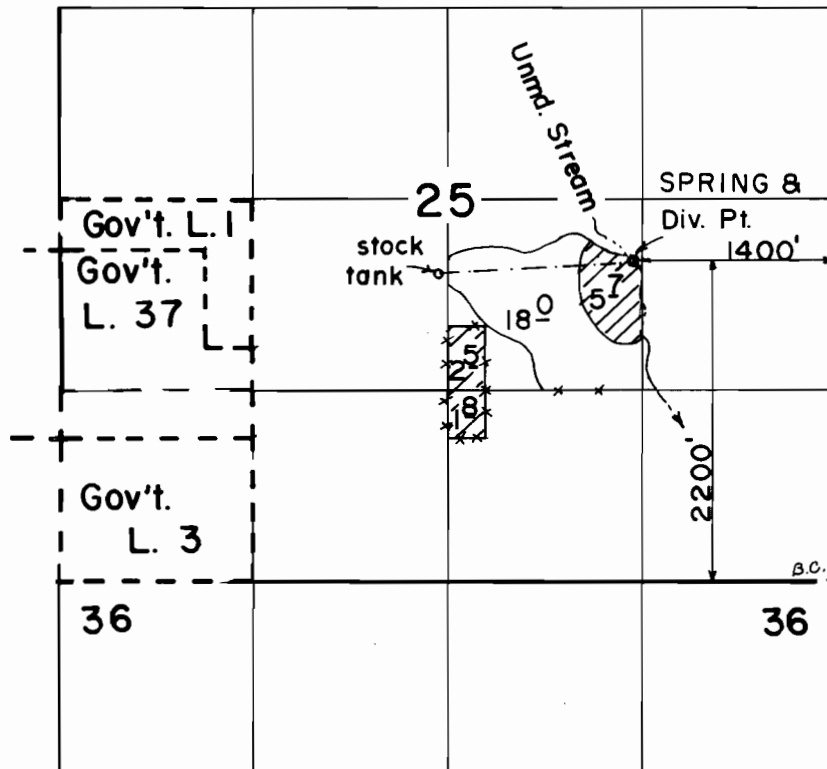

Scale: 1" = 1320'

FINAL PROOF SURVEY UNDER

Application No. 58134 Permit No. 44166
IN NAME OF

DANIEL L. &/or. MAE H. HILKEY

Surveyed JUN. 18. 19.87, by B. S. JAMES...