


T. 12S., R. 5W., W.M.

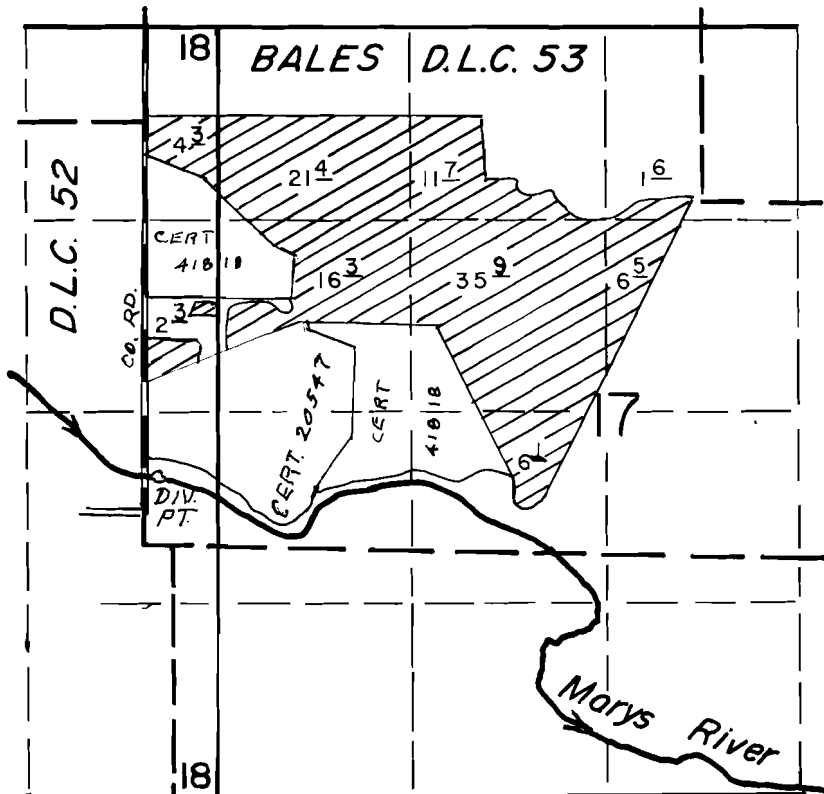

DIV. PT. LOC 2470' FEET SOUTH & 90' FEET EAST, N.E. COR. DLC 52

SCALE: 1" = 1320'

FINAL PROOF SURVEY UNDER

Application No. **58533**.. Permit No. **44194**.....
IN NAME OF

CROCKER FARMS

Surveyed **MAY 5**..... **1987**., by **T.M. WARREN**.....