


T. 35 S., R. 4 W., W.M.

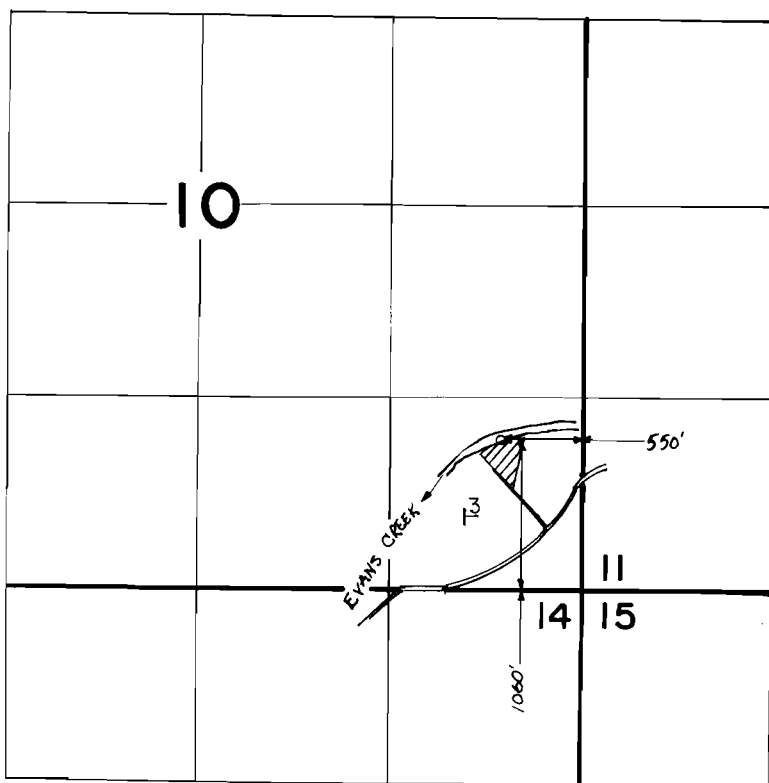

FINAL PROOF SURVEY UNDER

Application No. .58622. Permit No. .44233.....
IN NAME OF

AL T. &/OR DELLORA L. WESSON

Surveyed .DEC...12, 1983., by .B.S. JAMES.....