


T. 38 S., R. 6 W., W. M.

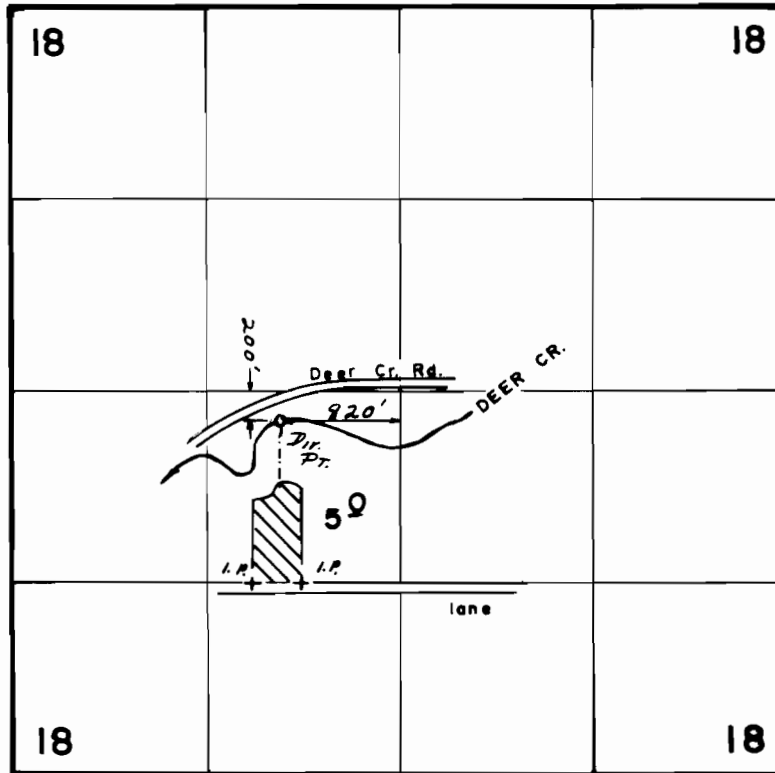

Scale: 1" = 1320'

FINAL PROOF SURVEY
UNDER

Application No. **58600** Permit No. **44234**
IN NAME OF

MRS. EARL W. LARSEN.

Surveyed **JUN. 5. 19.86**, by **B. S. JAMES.**