


T.3S., R.4W., W.M.

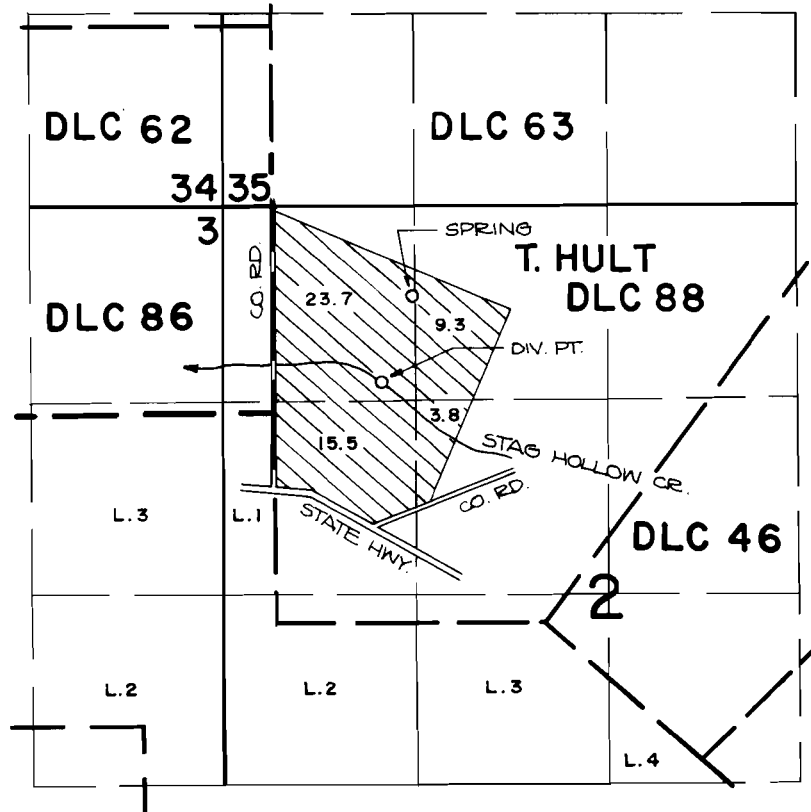

DIV. PT. LOCATION: 1620 FT. N. AND 710 FT. E.;
SPRING LOCATION: 2240 FT. N. AND 930 FT. E.;
BOTH FROM THE S.W. CORNER OF T. HULT D.L.C. 88.

FINAL PROOF SURVEY UNDER

SCALE: 4" = 1 MILE

Application No. 58724 Permit No. 44266.....
IN NAME OF

DON HUEGE

Surveyed JUNE 1, 1984, by P. P. Patten