


T.2N. R.12E. W.M.

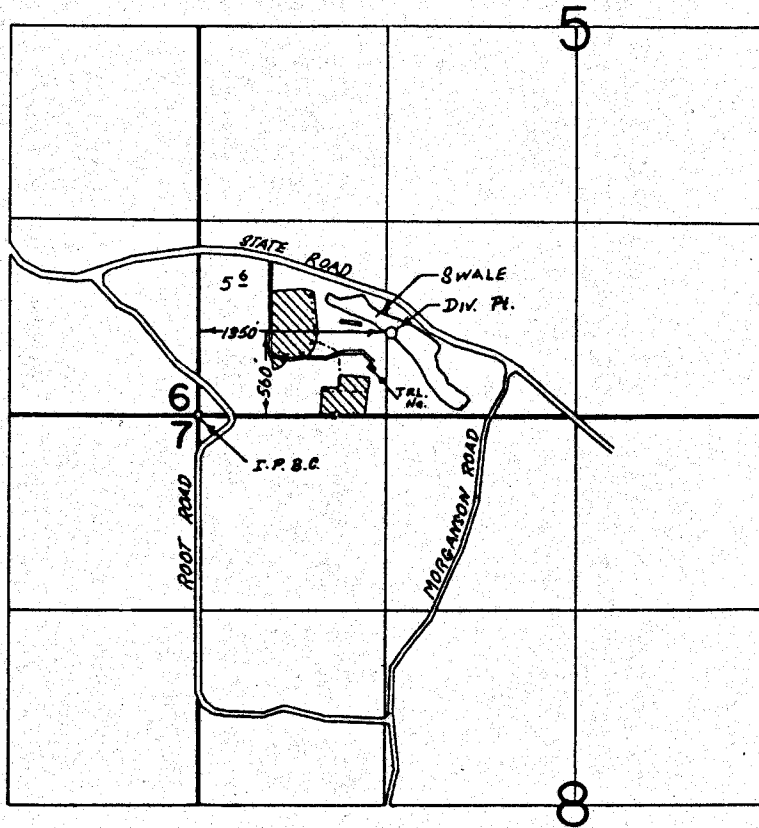

**FINAL PROOF SURVEY**  
UNDER

Application No. 58488.. Permit No. 44268..  
IN NAME OF

.....SAMUEL P. SMITH.....

Surveyed Oct. 30 1984, by T. Paul.....