


T. 40 S., R. 9 W., W. M.

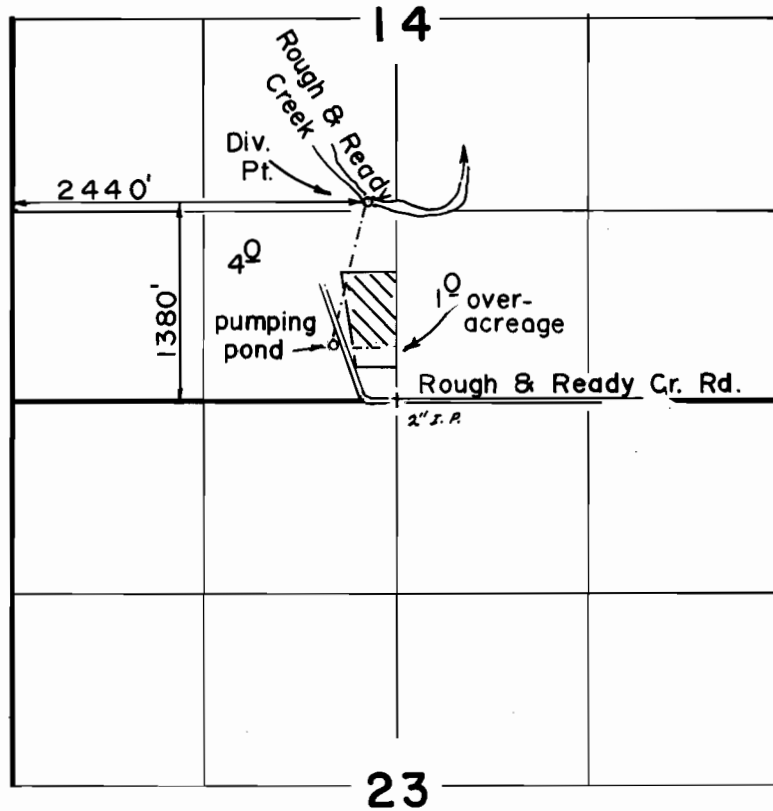

Scale: 1" = 1320'

FINAL PROOF SURVEY UNDER

Application No. **58768** Permit No. **44332**
IN NAME OF

.....**ERROS W. FEEHELY**.....

Surveyed APR...10.. 19.8.6, by **B...S.....JAMES.**