


T. 27 S., R. 6 W., W.M.

ONE 1/4 OF

SECTION 15 (SEE FIELD)

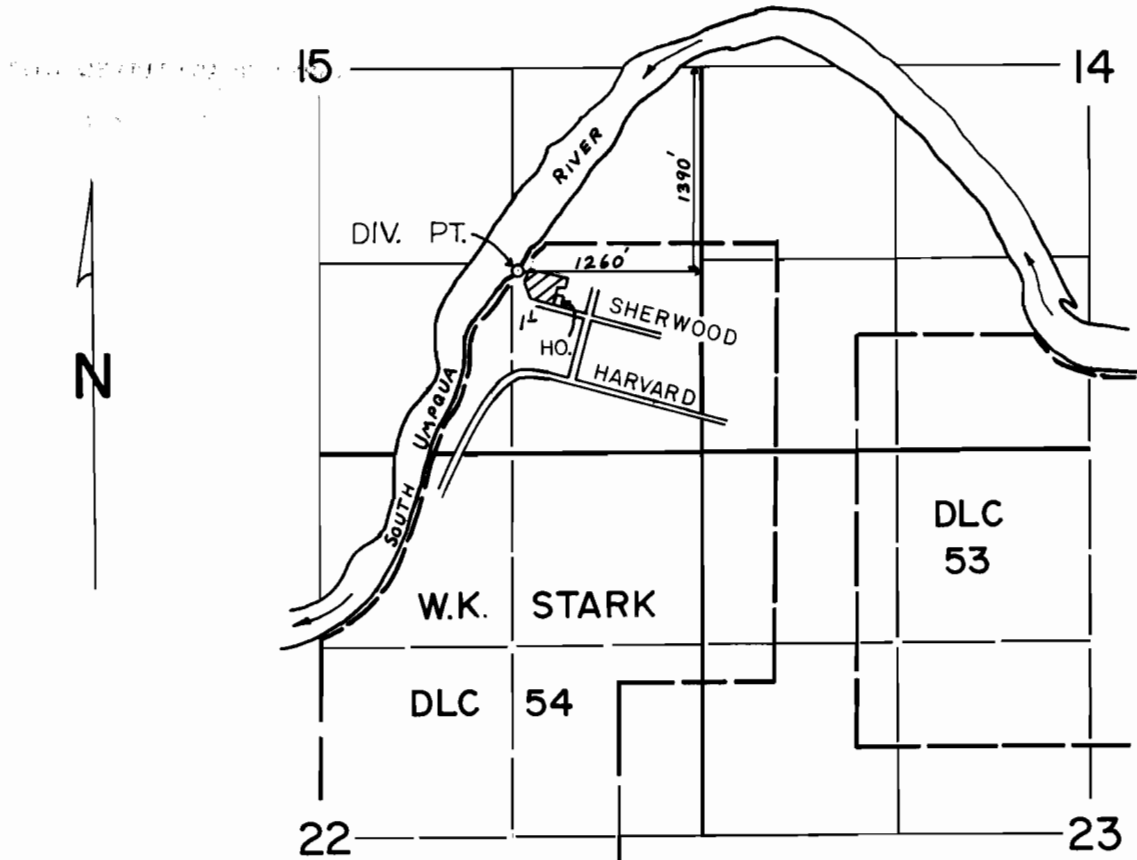

SCALE: 4" = 1 mile

FINAL PROOF SURVEY
UNDER

Application No. 58842 Permit No. 44356
IN NAME OF

.....THOMAS A. DAVIS.....

Surveyed DEC.....7.... 19.83., by *L. E. Cashman*