


T.26S.,R.6W.,W.M.

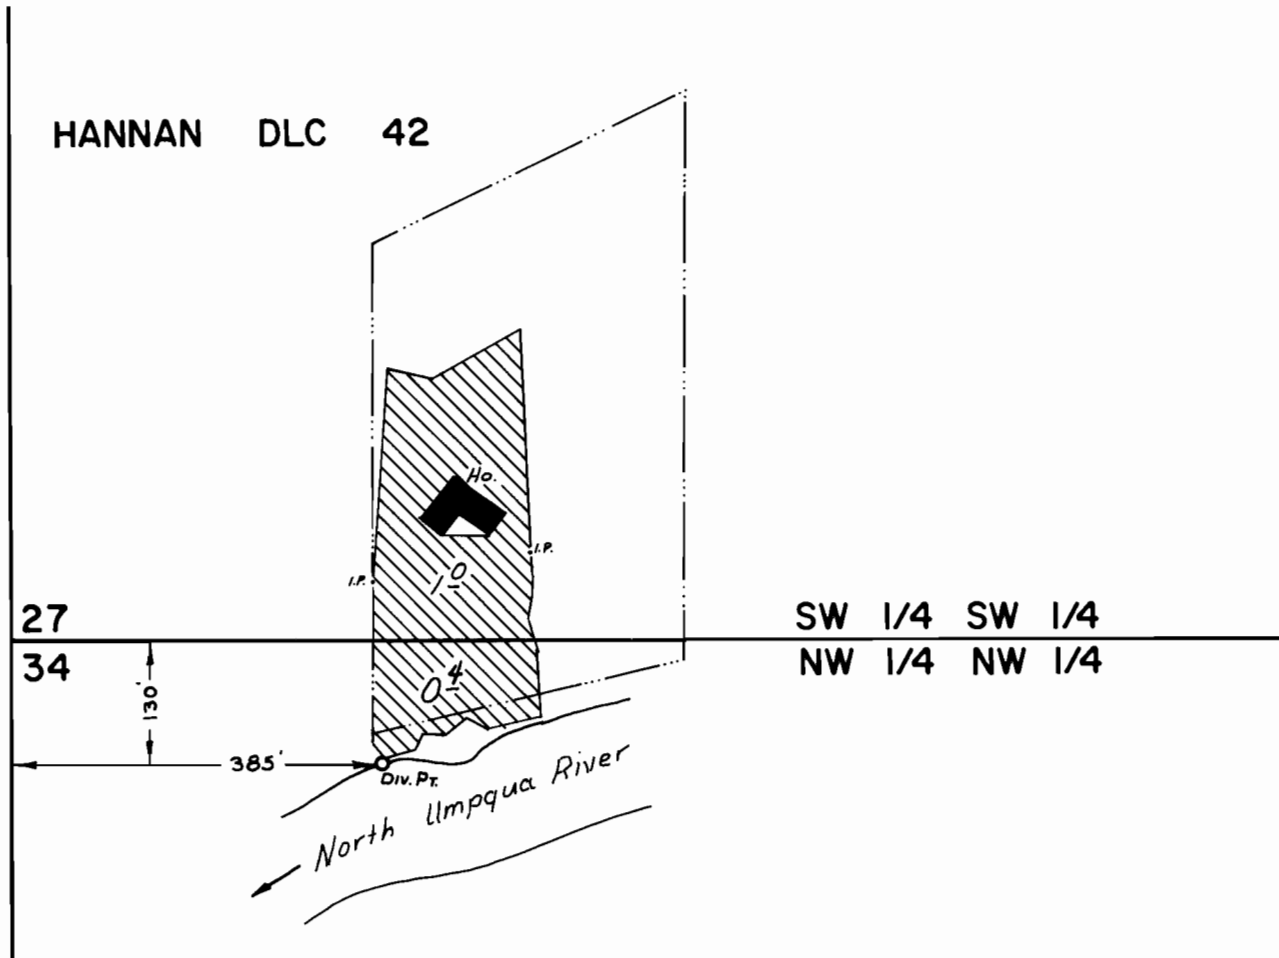

SCALE: 1" = 200'

FINAL PROOF SURVEY UNDER

Application No. 58822 Permit No. 44358
IN NAME OF

ROBERT L. SCHAFER

Surveyed July 21, 1982, by L.M. TOLL