



T.13S.,R.31E.,W.M.

Section 30

NW 1/4 NE 1/4

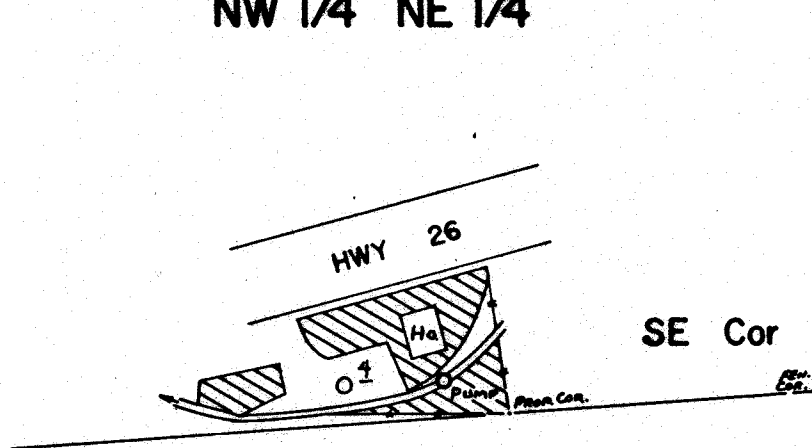

SCALE - 1" = 200'

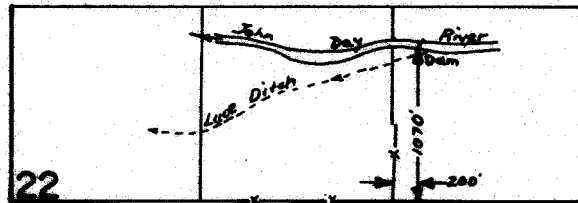

SCALE - 1" = 1320'

FINAL PROOF SURVEY UNDER

Application No. ...58884. Permit No. ...44379....
IN NAME OF

BILL WILCOX

Surveyed ..July...7... 1983., by ..R..W..Cattel.....