


T.5S.R.10W.W.M.

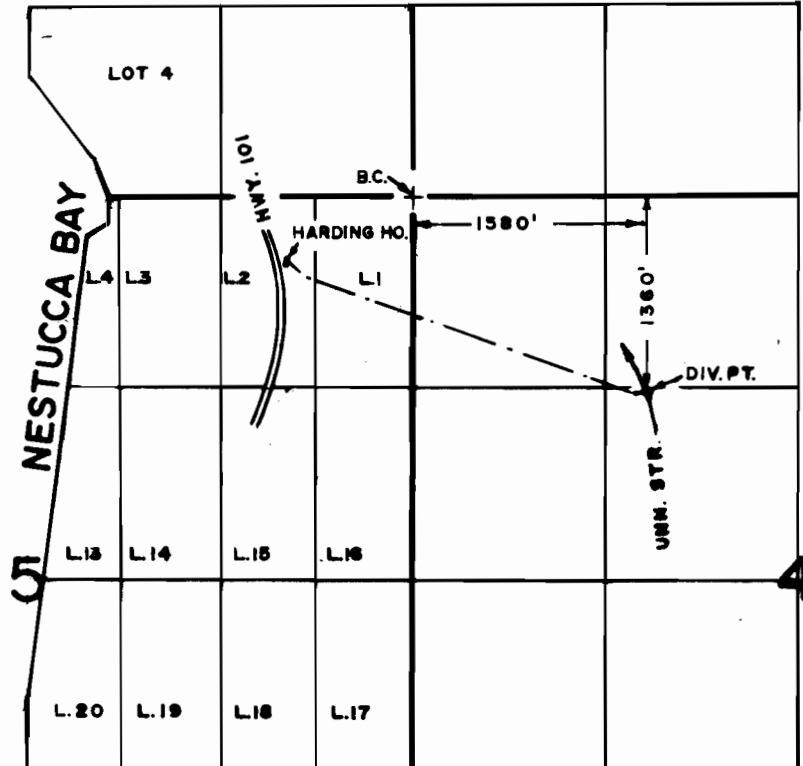

FINAL PROOF SURVEY
UNDER

Application No. 59011.... Permit No. 44401.....
IN NAME OF

.....WAYNE H. HARDING.....

Surveyed JAN. 22. 1980., by R.G. MUCKEN.....