
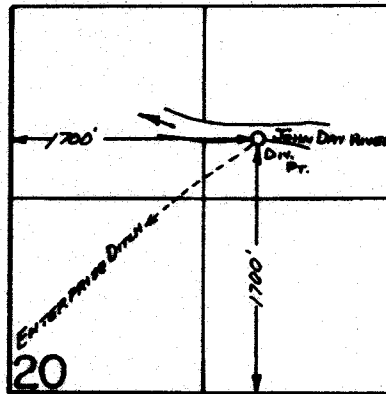


T.13S.,R.30E.,W.M.

T.13S.,R.31E.,W.M.

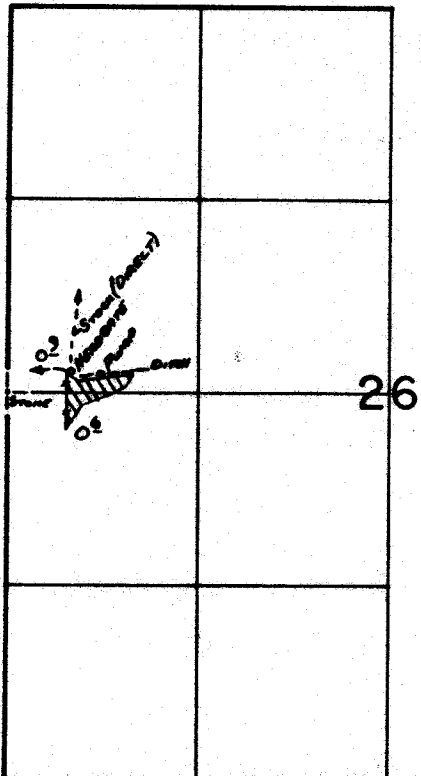

FINAL PROOF SURVEY
UNDER

Application No. ..58739.. Permit No. ...44418.....
IN NAME OF

.....**GEORGE HANSEN**.....

Surveyed Aug. 25... 1983., by ..R. W. Cattel.....