


T.4S. R.14E. W.M.

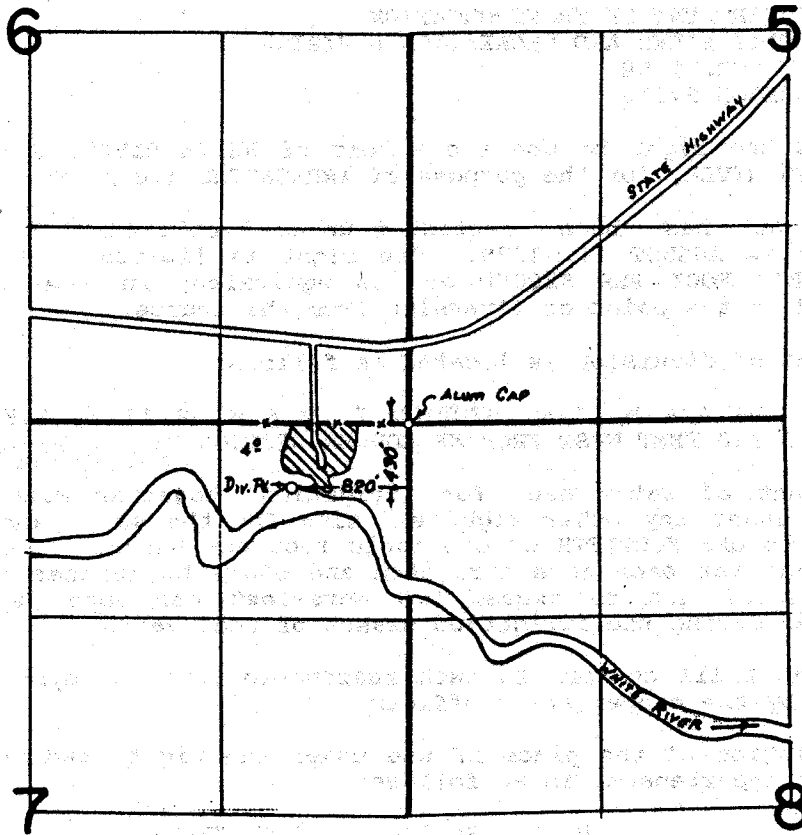

FINAL PROOF SURVEY
UNDER

Application No. 59216.... Permit No. 44471....

IN NAME OF
OREGON STATE PARKS & RECREATION DIVISION
OREGON DEPARTMENT OF TRANSPORTATION

Surveyed May 16, 1983, by T. J. Paul.....