


T.24S. R.5W. W.M. SECTION 33

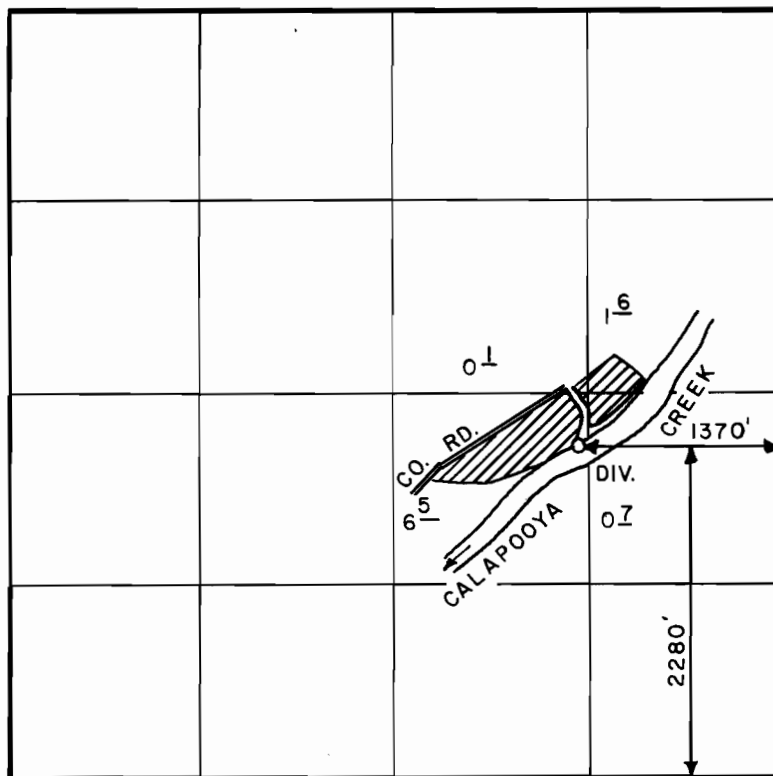

SCALE: 4" = 1 MILE

FINAL PROOF SURVEY UNDER

Application No. 58969 Permit No. 44490
IN NAME OF

ROBERT H. HOGAN

Surveyed OCT. 14 1986, by J.M. SCHMORDE