




T.27S.,R.14W.,W.M.

SECTION 33

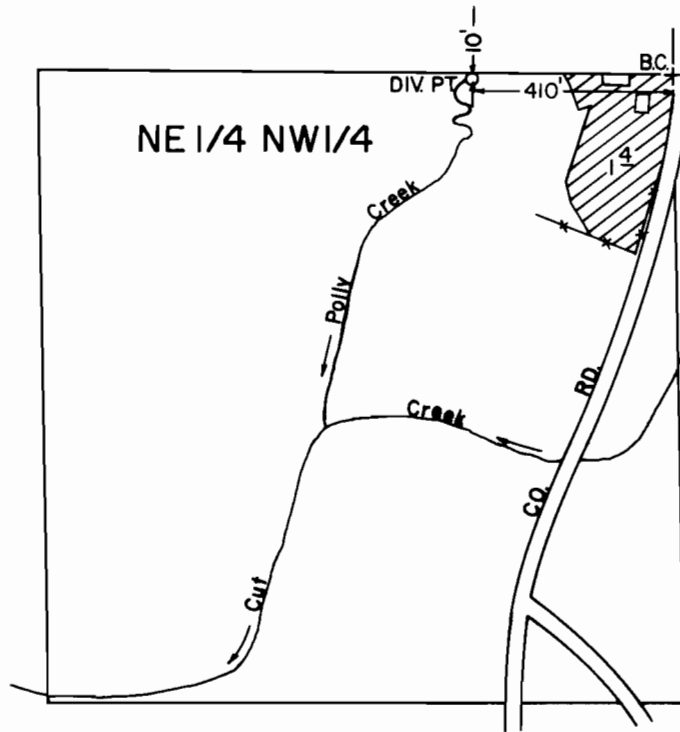

SCALE: 1" = 400'

**FINAL PROOF SURVEY**  
UNDER

Application No. 59202.. Permit No. 44497.....  
IN NAME OF

.....EARLINE N. DAVIS.....

Surveyed SEPT. 18. 1988., by L. H. NUNN.....