
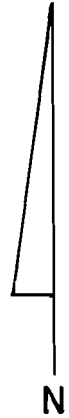


T. 1 S., R. 8 W., W.M.

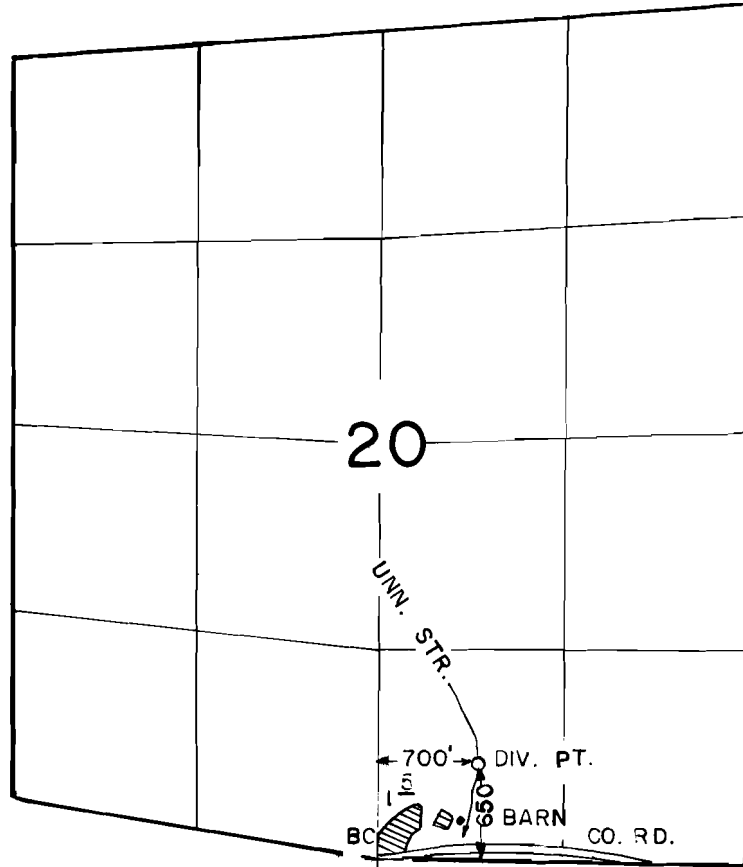

SCALE
1" = 1320'

FINAL PROOF SURVEY
UNDER

Application No. 58919 Permit No. 44514
IN NAME OF

GEORGE W. OVERLY

Surveyed JUN 13, 1985, by P. PAGTER