


T. 36 S., R. 4 W., W.M.

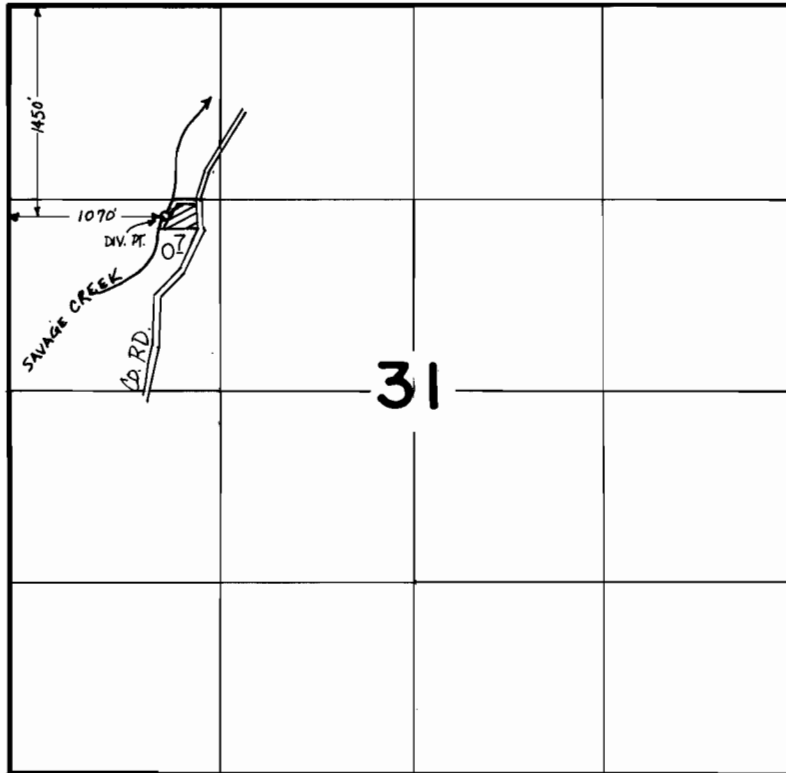

FINAL PROOF SURVEY
UNDER

Application No. 59275.. Permit No. 44540.....
IN NAME OF

THOMAS C. ARRINGTON

Surveyed JUNE 13, 1983, by B.S. JAMES.....