


T. 36 S., R. 4 W., W.M.

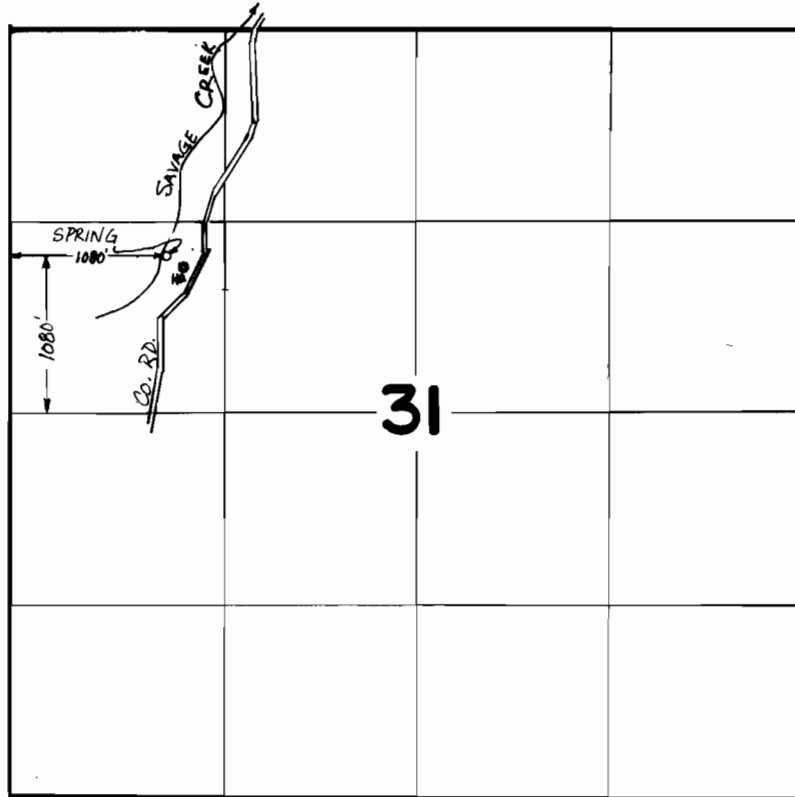

FINAL PROOF SURVEY UNDER

Application No. 58976.. Permit No. 44575....
IN NAME OF

DAVID K. ROUGHTON

Surveyed JUNE 13, 1983., by B. S. JAMES.....