


# T.13S., R.31E., W.M. SECTION 25

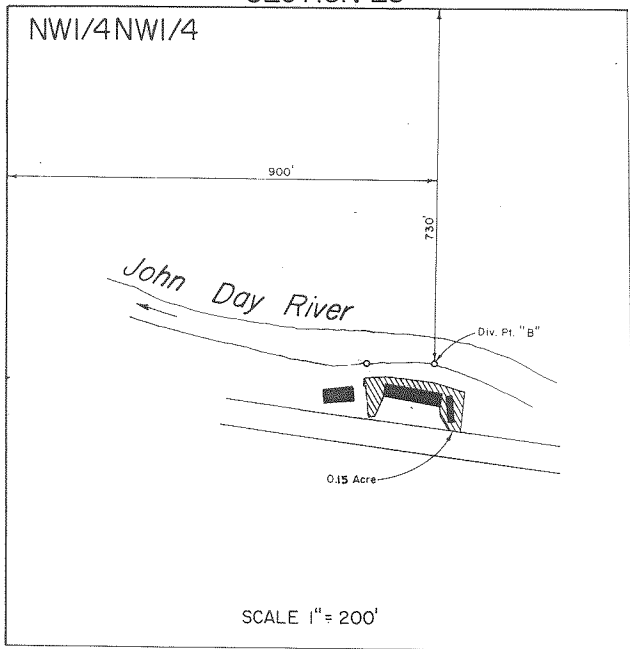

## FINAL PROOF SURVEY UNDER

Application No. 59311 Permit No. 44609  
IN NAME OF

RAYMOND FOOKS

Surveyed OCT. 8, 1981, by John Brown