


T. 26 S., R. 5 W., W.M.

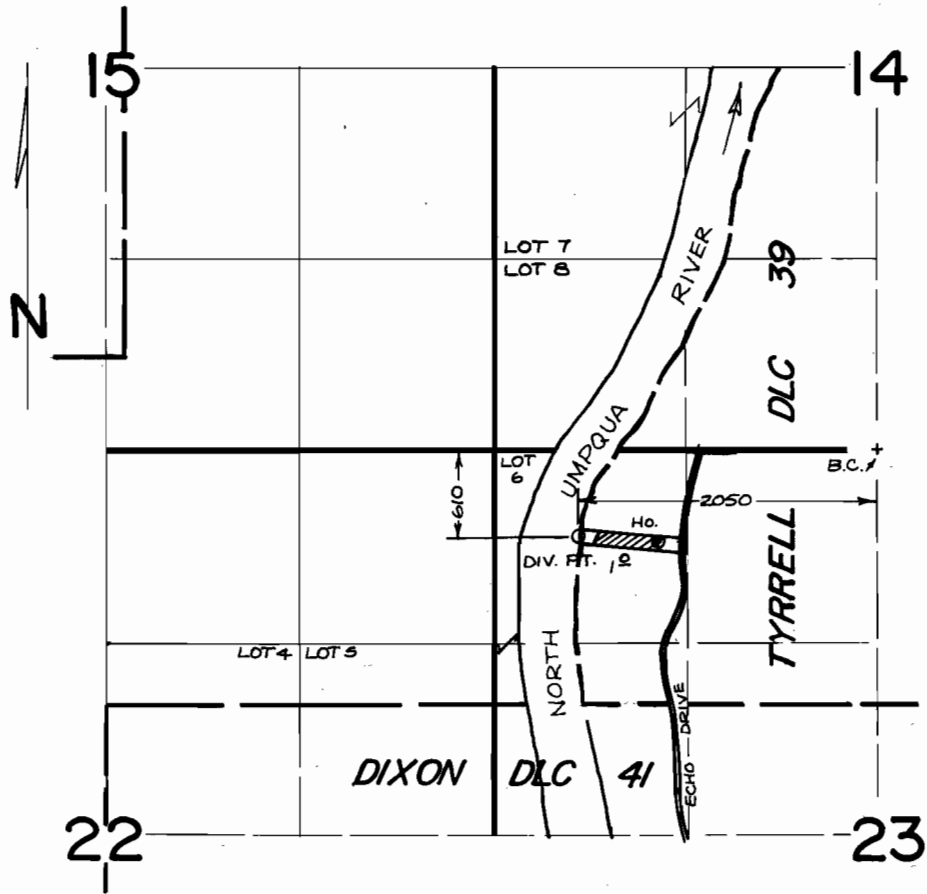

SCALE : 4" = 1 MILE

FINAL PROOF SURVEY UNDER

Application No. ...59377. Permit No.44647...
IN NAME OF

.....CHARLES SUMEY.....

Surveyed ..OCT...9., 19.86, by ...J.M..SCHMORDE