


T.39 & 40S., R.3W., W.M.

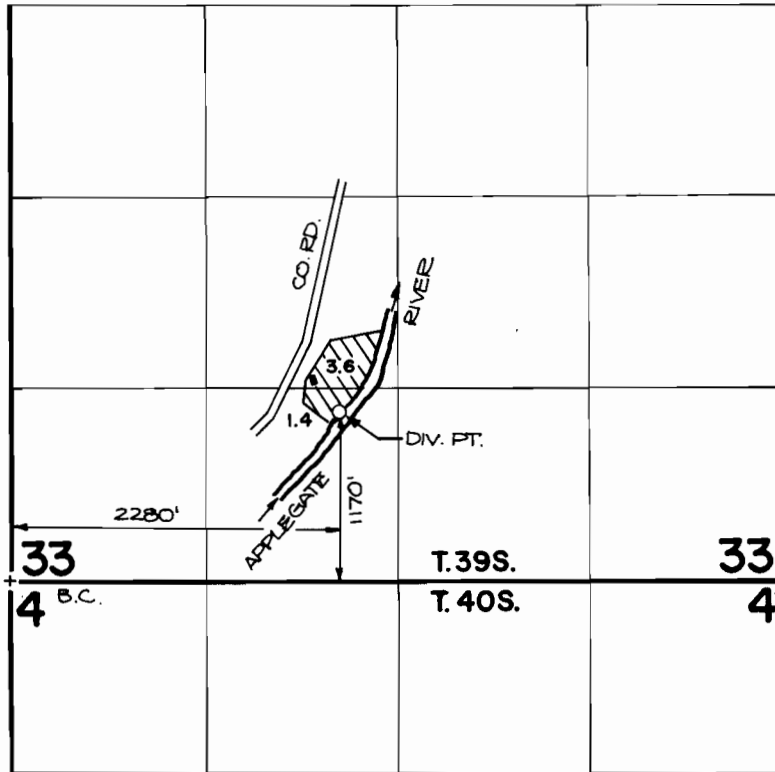

FINAL PROOF SURVEY UNDER

Application No. **58710**... Permit No. **44687**....
IN NAME OF

CHESTER AND/OR LINDA HALSEY

Surveyed **JULY 14**... 19**83**, by **B. JAMES**.....