


T. 27 S., R. 4 W., W.M. SECTION 31

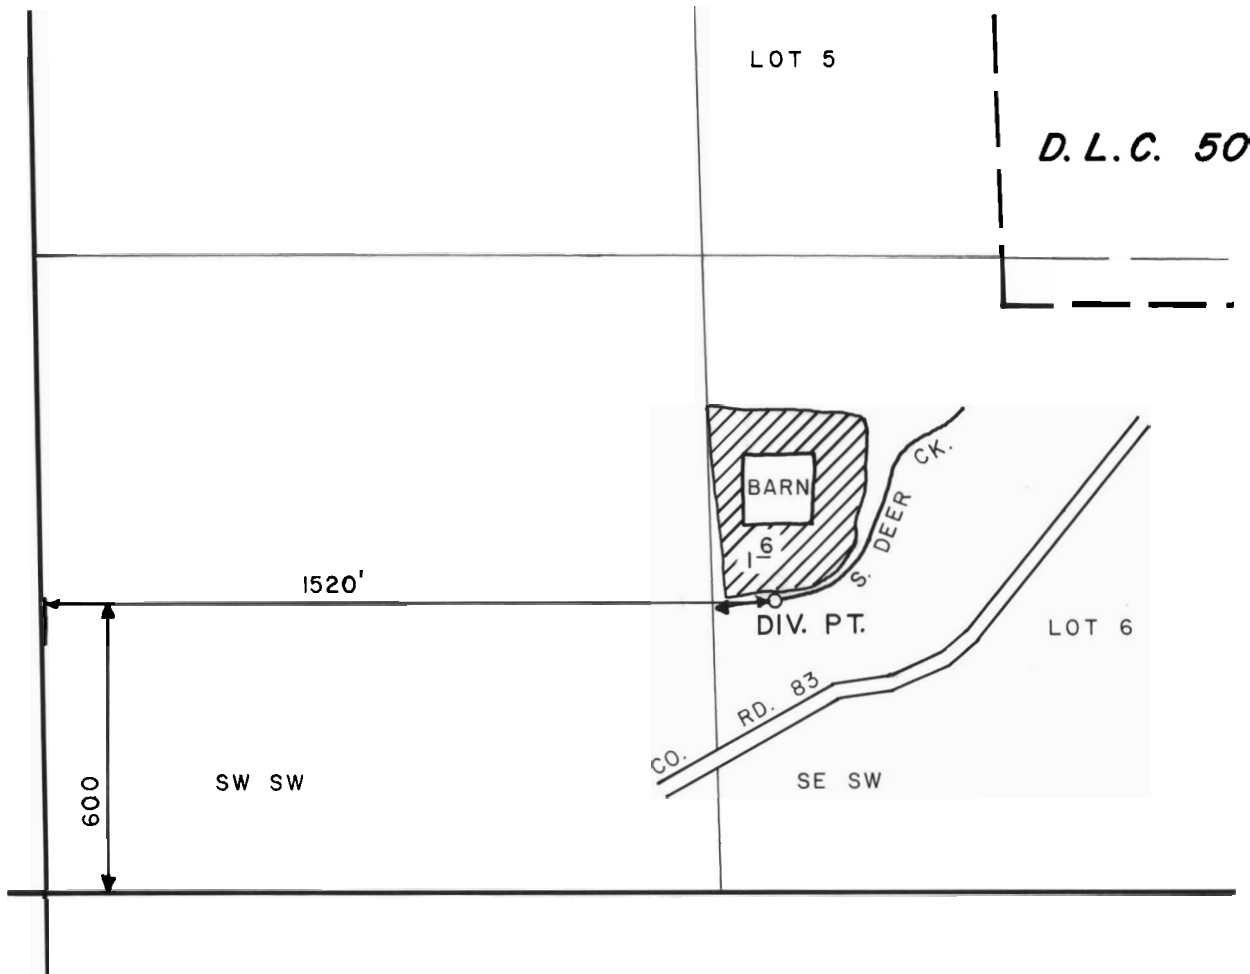

SCALE: 1" = 400'

FINAL PROOF SURVEY UNDER

Application No. 59381... Permit No. 44698....
IN NAME OF

RICHARD & CASSANDRA STEED

Surveyed JUNE 13, 1986., by J.M. SCHMORDE