


T.16S.,R.2E.,W.M.

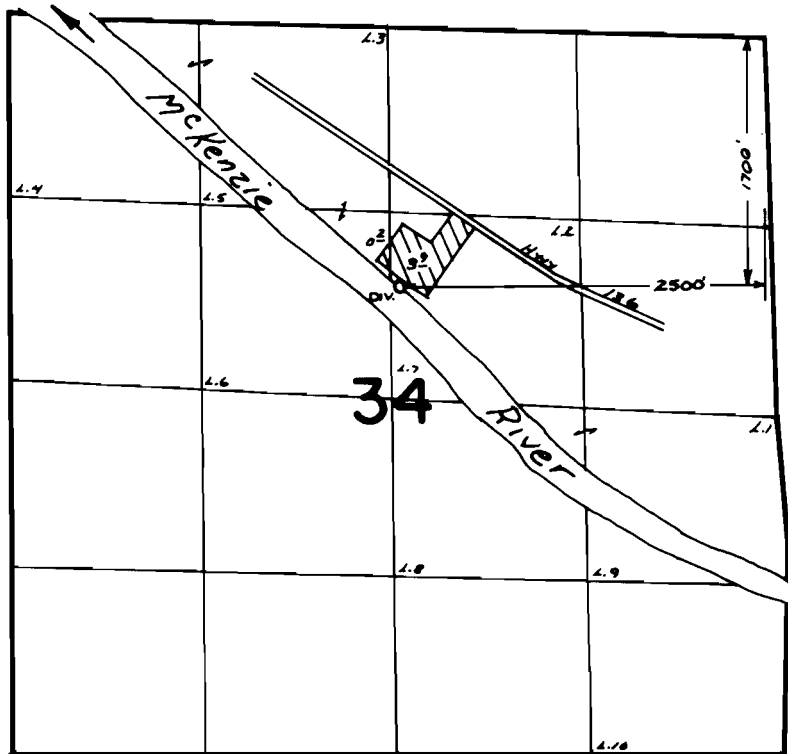

**FINAL PROOF SURVEY**  
UNDER

Application No. 59443 Permit No. 44805  
IN NAME OF

**DONALD K. & HELEN T. SILLS**

Surveyed Aug. 21, 1981, by S. C. BROWN