


# T. 5S., R. 6 W., W. M.

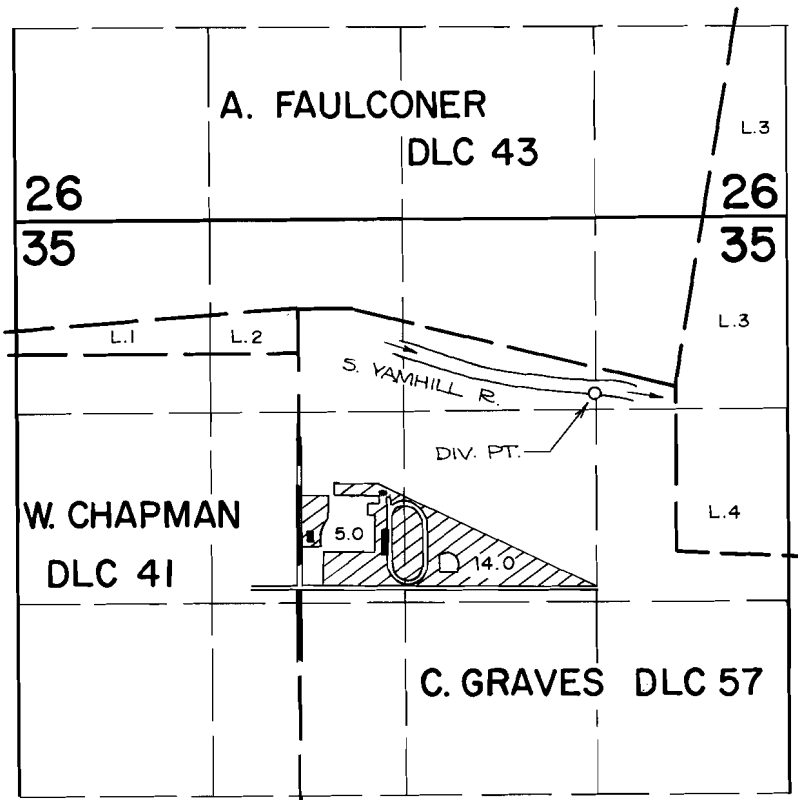

DIV. PT. LOCATION: 1440 FT. N. AND 1330 FT. W. FROM THE E. 1/4 CORNER.

## FINAL PROOF SURVEY UNDER



SCALE: 4" = 1 MILE

Application No. 60037 Permit No. 44812  
IN NAME OF

SHERIDAN SCHOOL DISTRICT 48J

Surveyed OCT. 4, 1984, by P. Page