


T.2.N.R.4W.W.M.

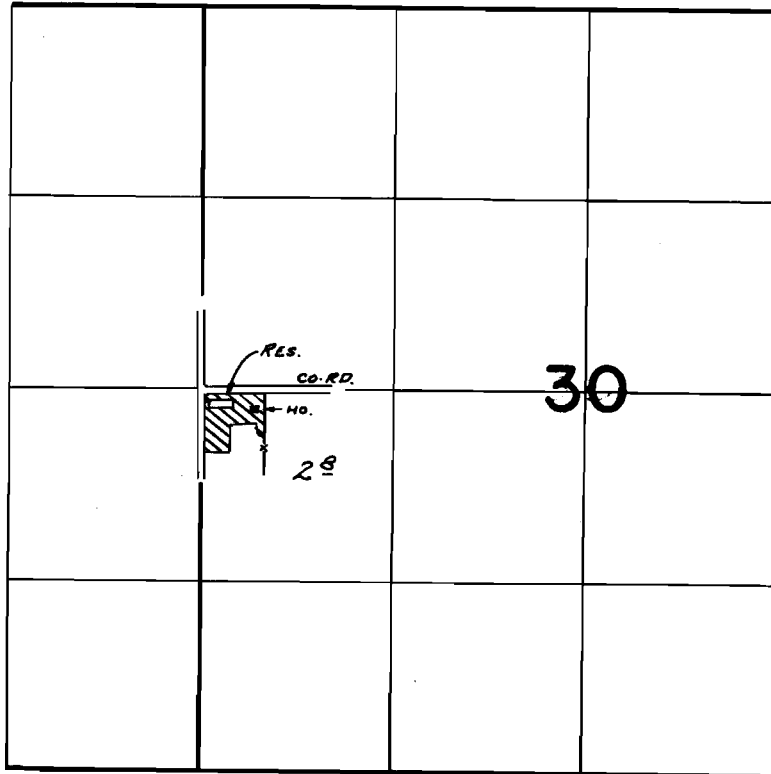

DIV. LOC: 80'S & 70'E FROM W. $\frac{1}{4}$ COR. SEC. 30

FINAL PROOF SURVEY UNDER

Application No. R-52625 52626 Permit No. R-6358 39608
IN NAME OF

LAWRENCE E. MARSHALL

Surveyed DEC 5, 1979, by R. MUCKEN