




T.27S.,R.11W.,W.M.

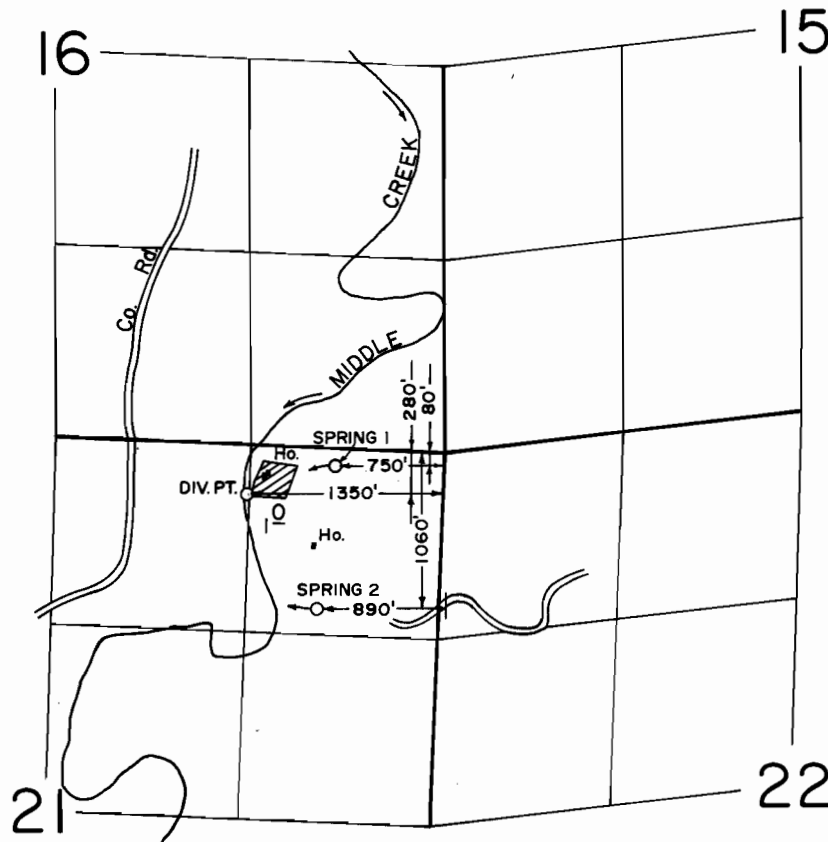

SCALE: 1" = 1320'

FINAL PROOF SURVEY UNDER

Application No. 58703 Permit No. 44848
IN NAME OF

DAVID CHRISTIAN

Surveyed SEPT. 20 1988, by Z. SALEH