


T. 6 S., R. 1 W., W.M.

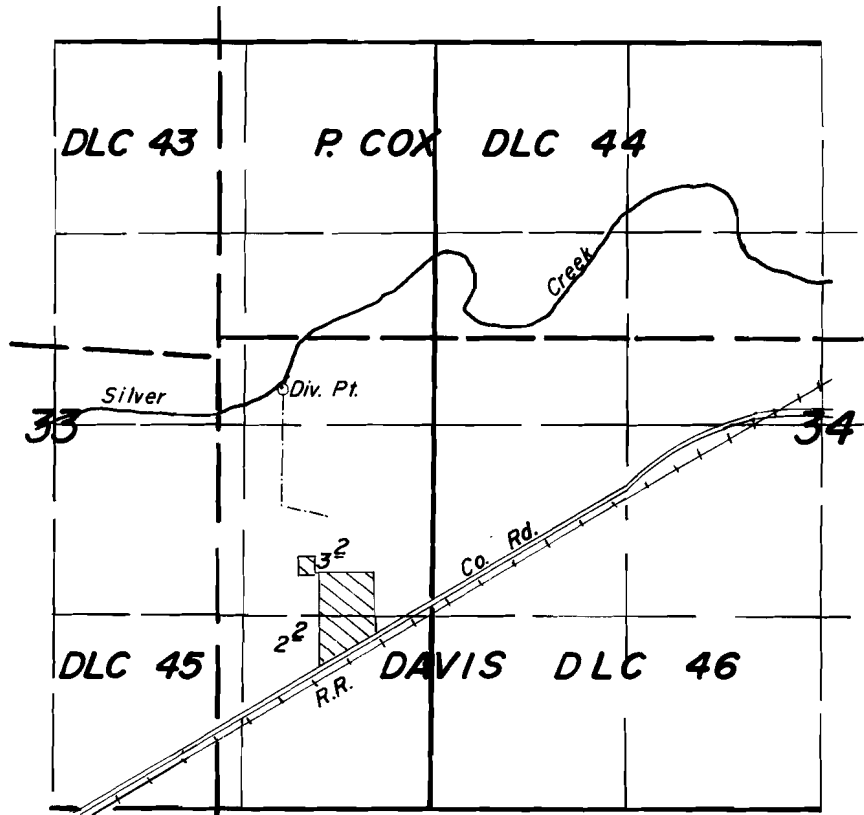

Div. Pt. Loc.: 350' S. & 450' E. from NW Cor. DLC 46.

1" = 1320'

FINAL PROOF SURVEY UNDER

Application No. 59826... Permit No. 44896...
IN NAME OF

DEWAYNE C. PARKER

Surveyed O.G.T. 3... 19.84, by T. Warren