
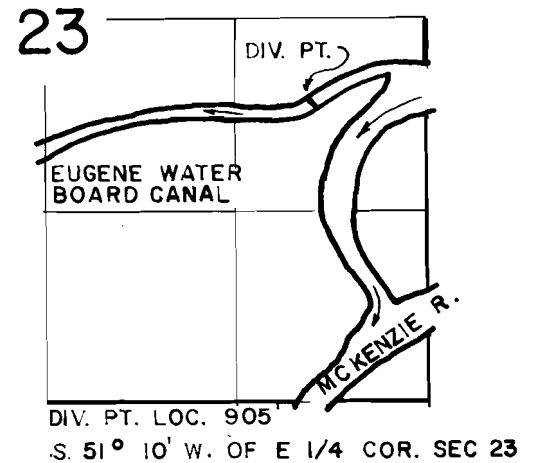
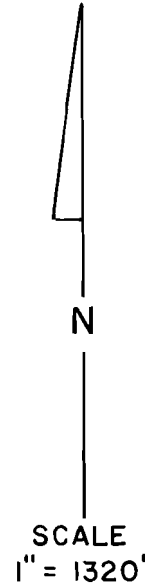


T. 17 S., R. 1 W., W.M.

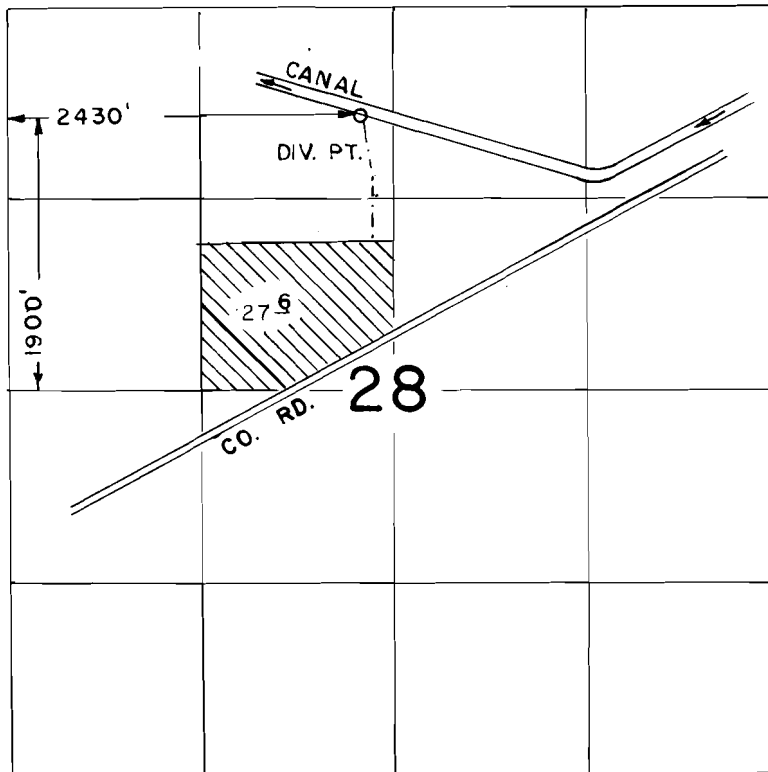

FINAL PROOF SURVEY UNDER

Application No. 60081... Permit No. 44898...
IN NAME OF

RALPH CLINE JR.

Surveyed JUN 25, 1984, by P. PAGTER...