


T. 2S., R. 39 & 40E., W.M.

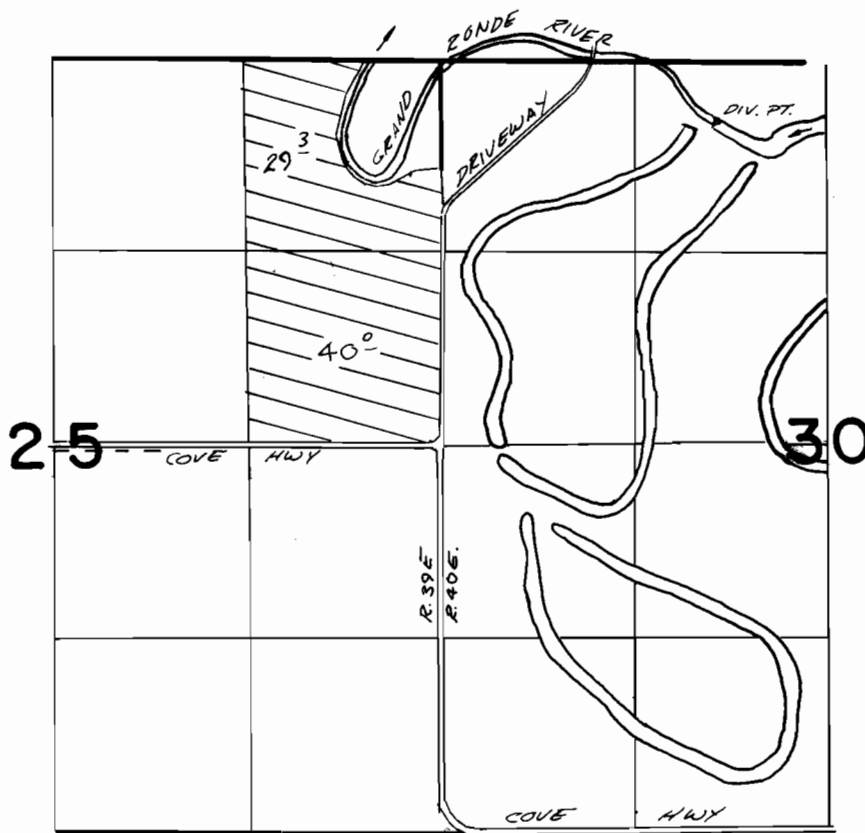

DIV. PT. LOCATED 500' S. & 1890' E. FROM NW COR SEC. 30, T. 2S., R. 40E. W.M.

FINAL PROOF SURVEY
UNDER

Application No. 59903 Permit No. 44904
IN NAME OF

JOHN P. HASSINGER

Surveyed Nov. 17 1981, by V.L. Church