
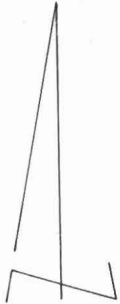


T. 8S., R. 39E., W.M.

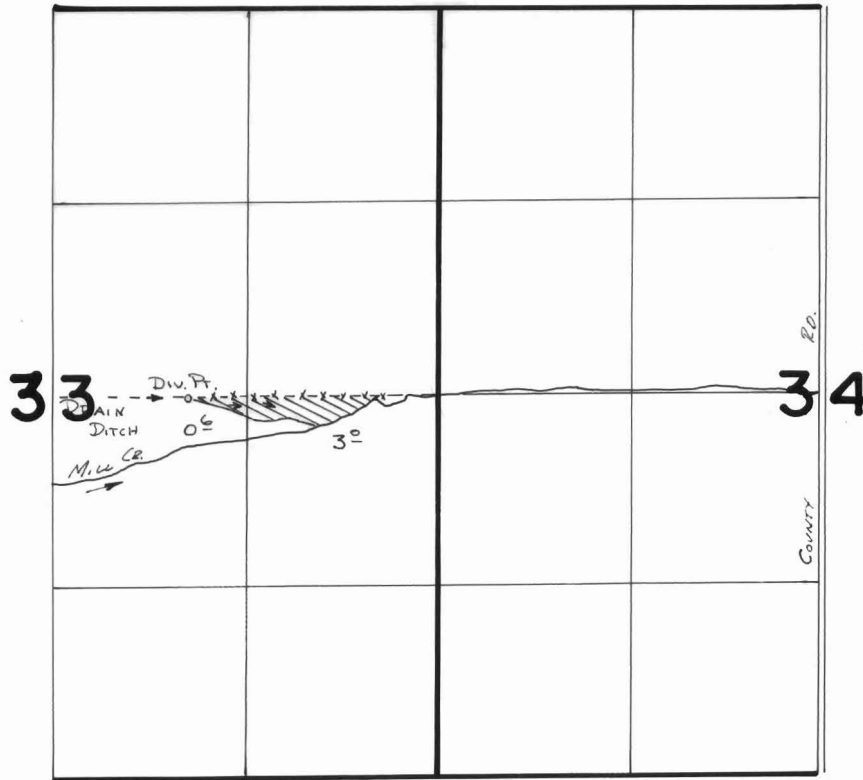

SCALE 1" = 1320'

Div. Pt. Loc: 930'E FROM CENTER SEC 33

**FINAL PROOF SURVEY**  
UNDER

Application No. **59401**. Permit No. **45213**.....  
IN NAME OF

.....**JACK**.....**ROUSE**.....

Surveyed ...**9-30**..... **19.87.**, by **V.L. Church**.....