


# T3S, RIOW, WM

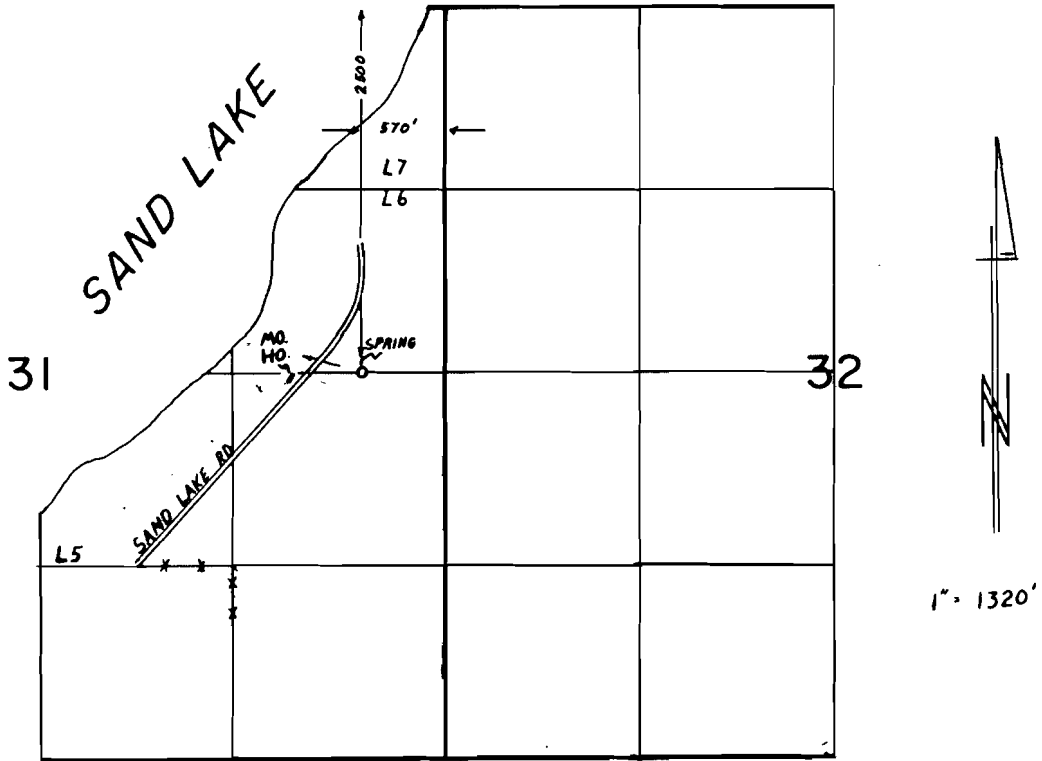

## FINAL PROOF SURVEY UNDER

Application No. 60896 Permit No. 45733  
IN NAME OF

.....RODNEY C. ANDERSEN.....

Surveyed SEPT. 29. 1987., by B. W. BISHOP.....