


T.8 S., R.42 E., W.M.

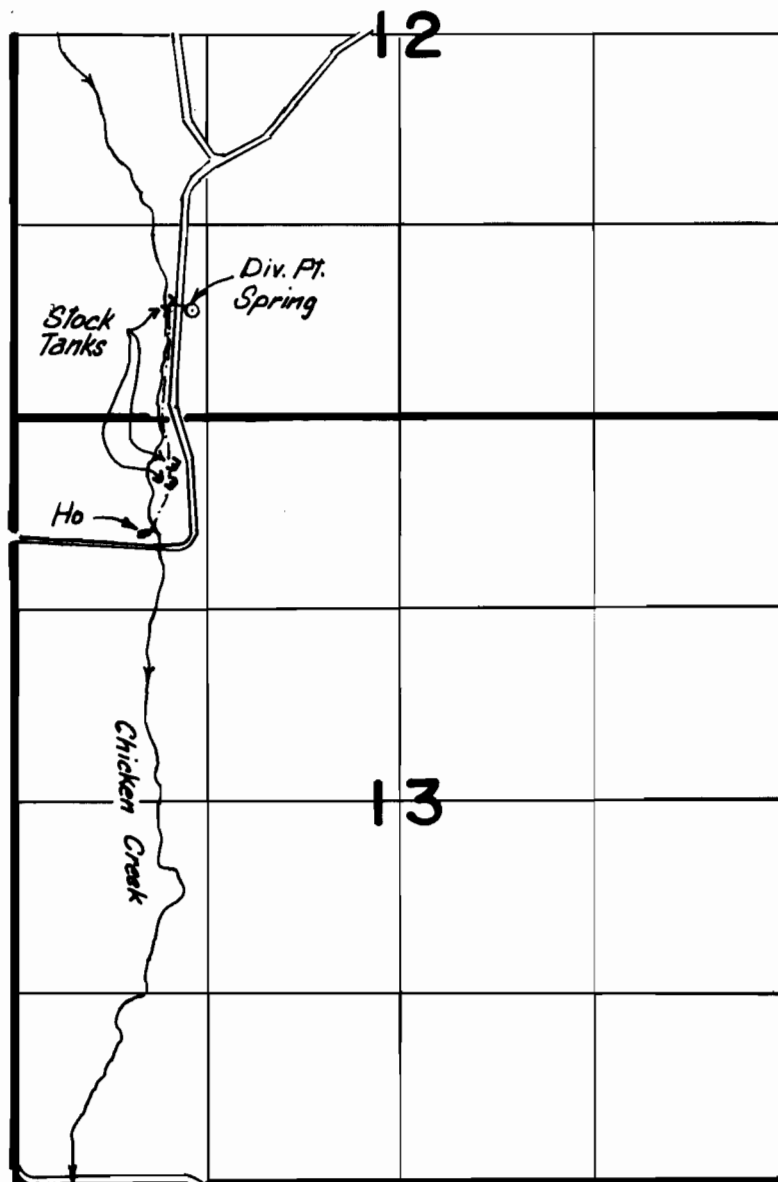

The point of diversion is located 740' N. & 1220' E. of the SW corner of section 12.

FINAL PROOF SURVEY

UNDER

Application No. 59565 Permit No. 45754
IN NAME OF

MICHAEL L. & CATHY S. COOK

Surveyed 8-31, 1988, by Vern Church

Scale 1" = 1320'