


T. 40 S., R. 13 W., W. M.

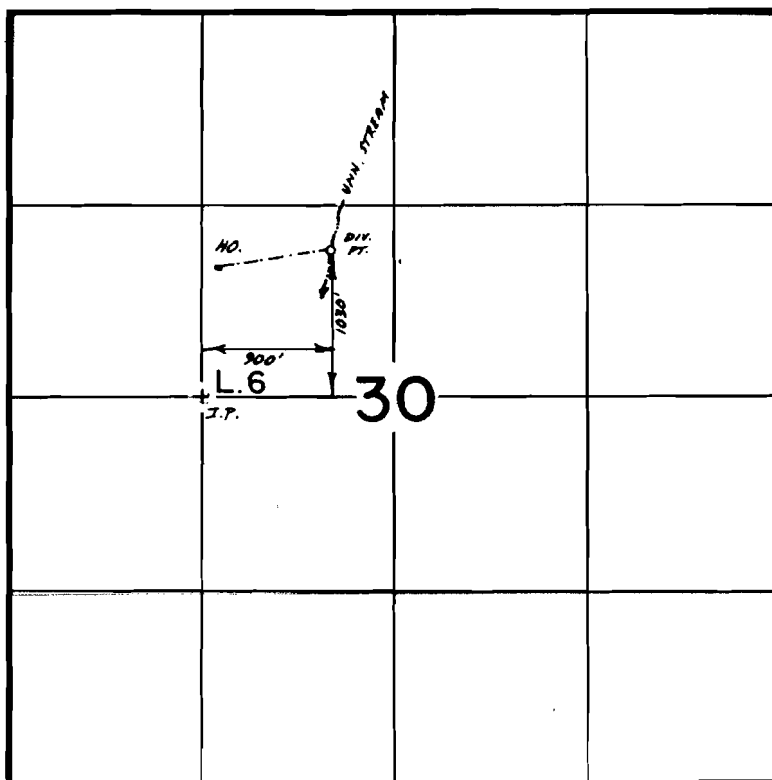

Scale 1"=1320'



FINAL PROOF SURVEY
UNDER

Application No. 61613... Permit No. 46129.....
IN NAME OF

M.C. STERNBURG & FLORENCE D. CLARK

Surveyed May 20, 1987, by J.M. SCHMORDE