


T. 22 S., R. 7 W., W. M.

SECTION 20

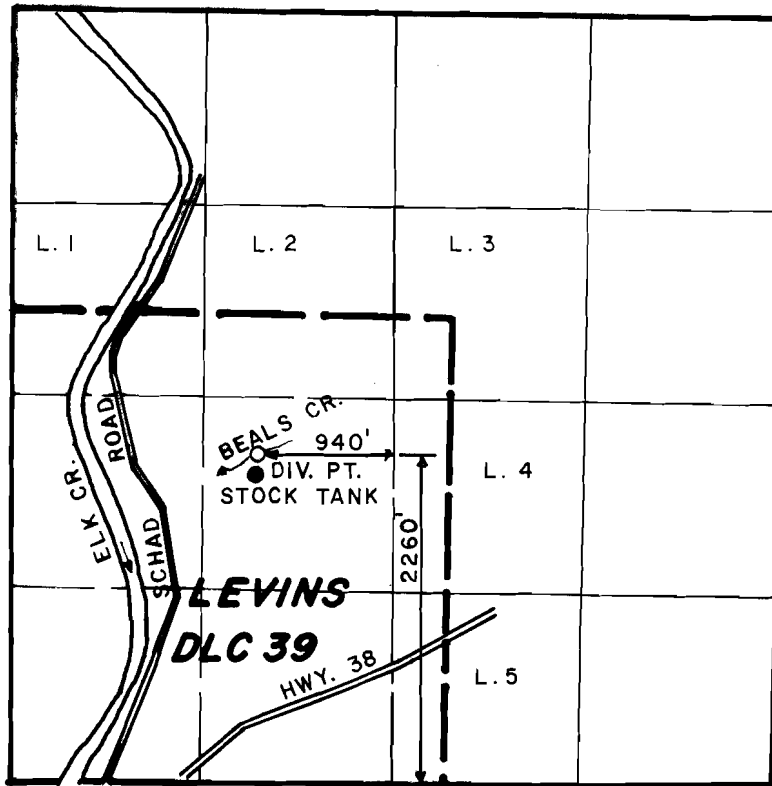

SCALE: 4" = 1 MILE

FINAL PROOF SURVEY
UNDER

Application No. 61875... Permit No. 46170...
IN NAME OF

WARREN AND FREDERICA SCHAD

Surveyed AUG. 25. 1987., by J. M. SCHMORDE