



T.9S., R.39E., W.M.

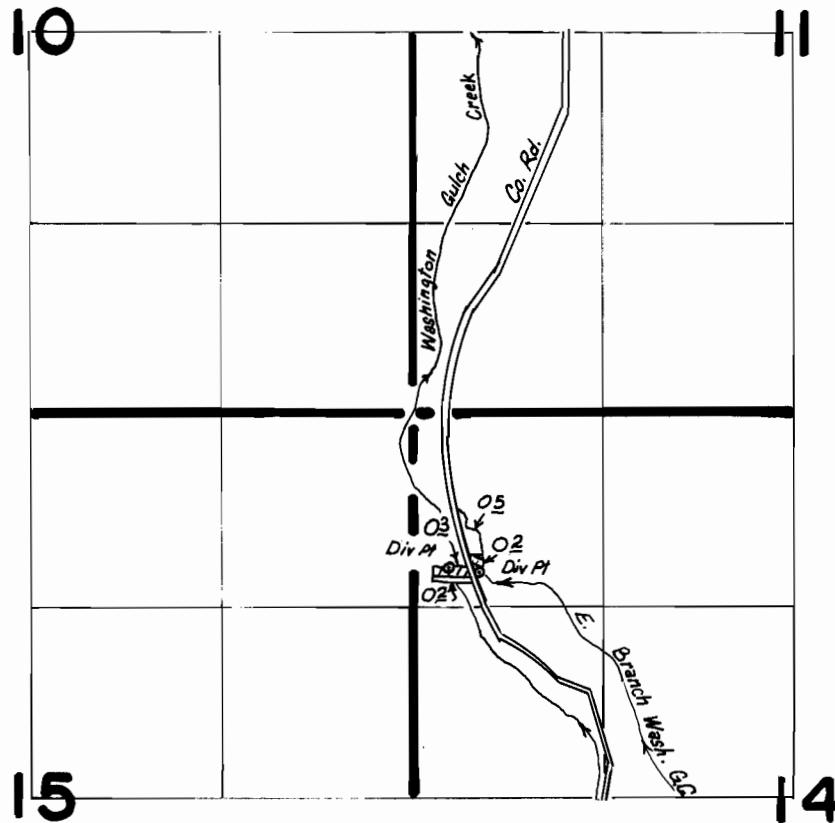

The location of div. pts. ; 1050' S. & 230' E., and
1100' S. & 450' E., both from NW cor. sec. 14.

 HILL
 NESTELL

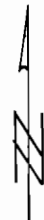

Scale: 1" = 1320'

FINAL PROOF SURVEY UNDER

Application No. **61889** Permit No. **46265**
IN NAME OF

MRS. LILLIAN NESTELL & CHESTER W. HILL

Surveyed **10-2** 1988, by **Vern Church**