


T. 38 & 39 S., R. 3 W., W. M.

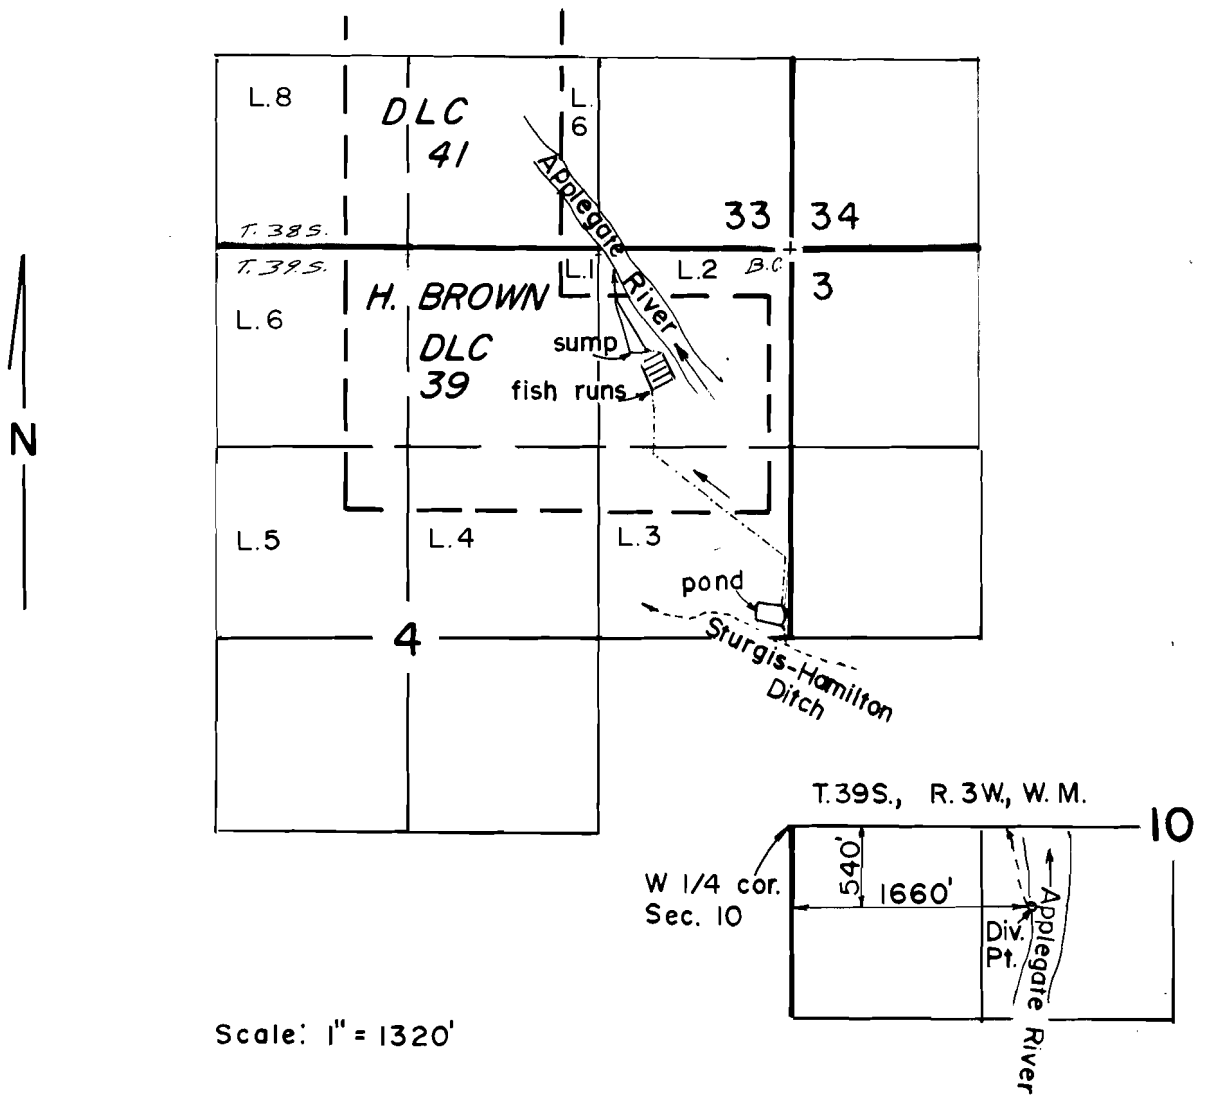

Scale: 1" = 1320'

FINAL PROOF SURVEY UNDER

Application No. 63023 Permit No. 46637...
IN NAME OF

GREGORY SNOW

Surveyed JAN. 12, 1988 by B. S. JAMES...
& APR. 28, 1988