


T. 40 S., R. 13 W., W.M.

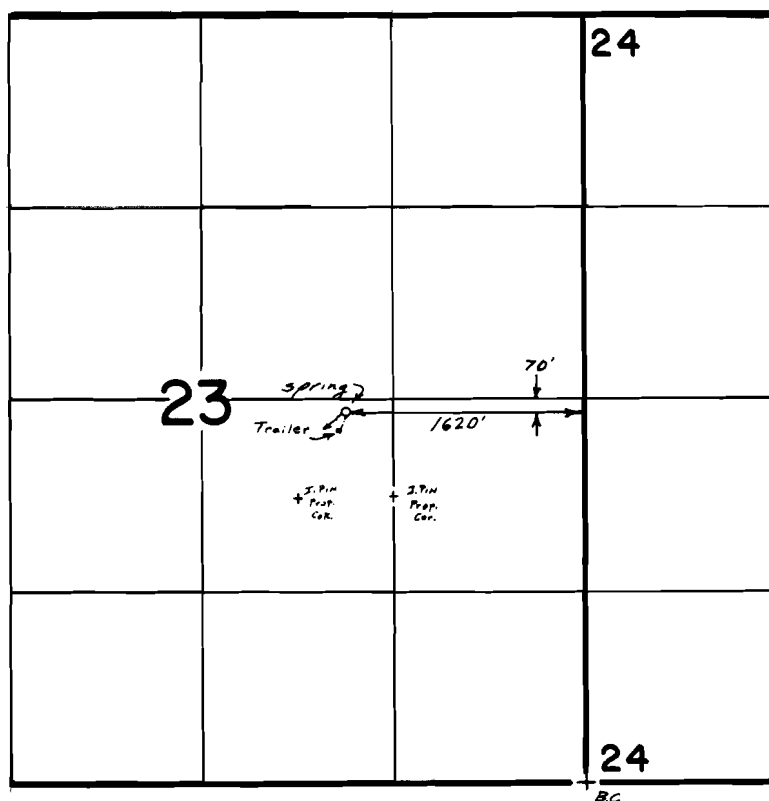

Scale 1" = 1320'



FINAL PROOF SURVEY

UNDER

Application No. 63628 Permit No. 46870
IN NAME OF

R.I.P. GARDNER

Surveyed Oct. 11, 1988, by B.S. JAMES