


T. 26 S., R. 3 W., W.M.

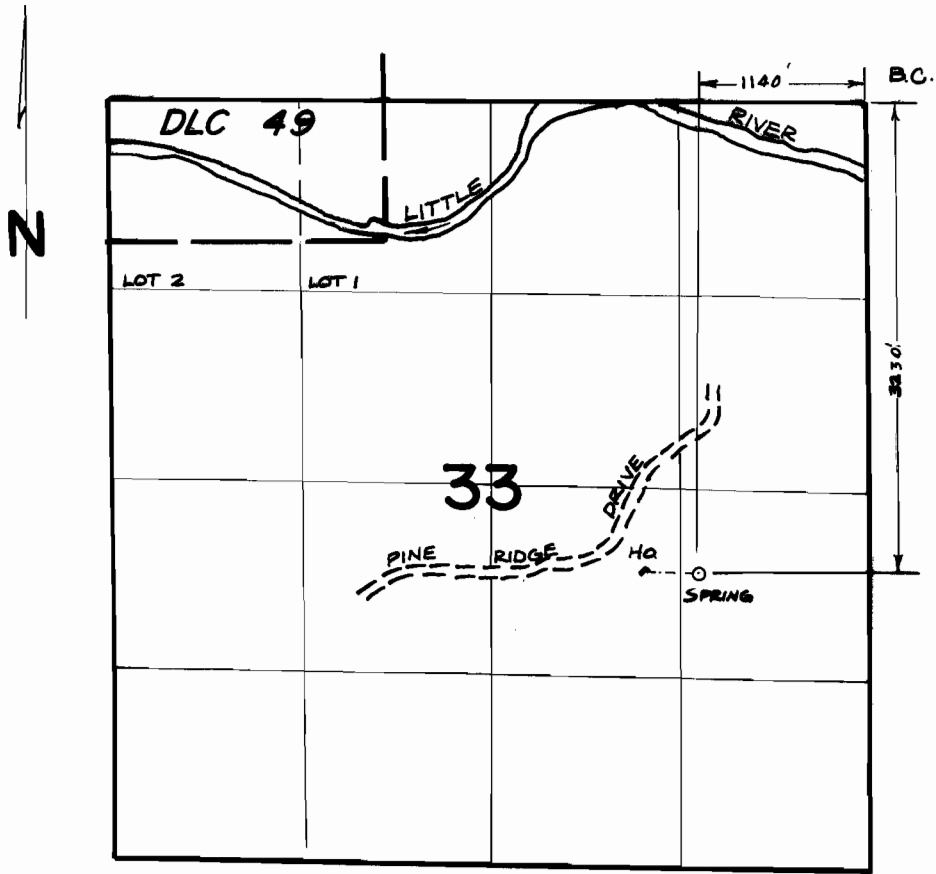

SCALE: 4" = 1 MILE

FINAL PROOF SURVEY UNDER

Application No. .64054. Permit No. .47131.....
IN NAME OF

.....**FRANK GAYLOR**.....

Surveyed SEPT. 30, 19.86, by ..J.M. SCHMORDE.