


T. 26 S., R. 3 W., W.M.

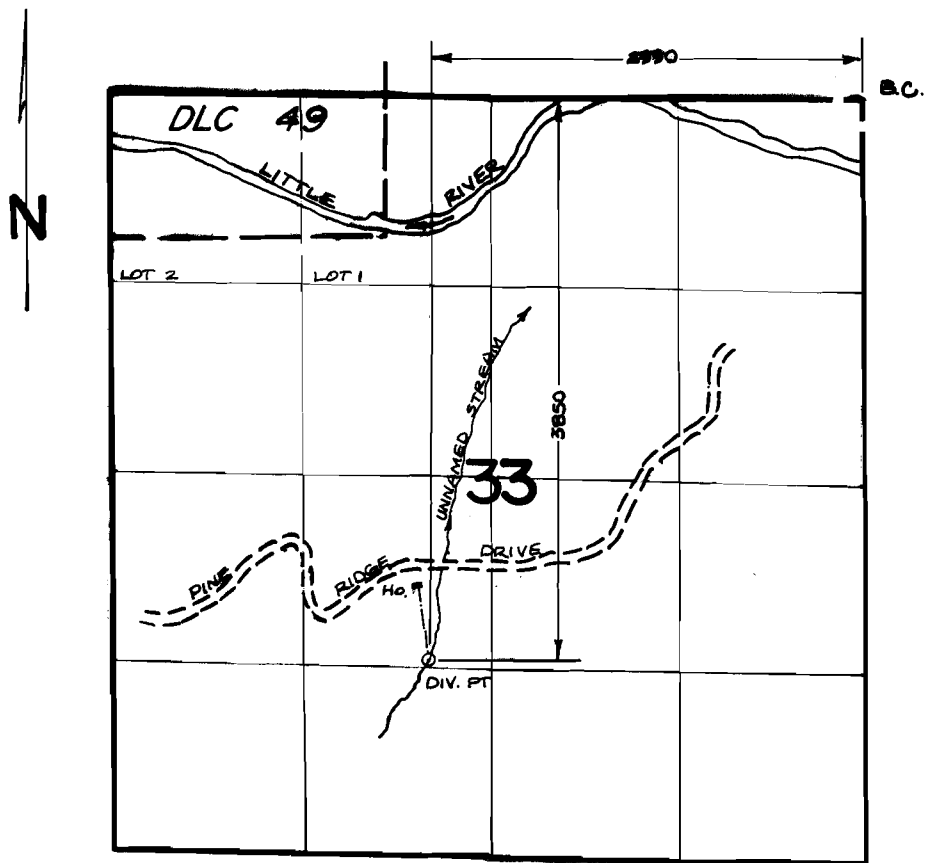

SCALE: 4" = 1 MILE

FINAL PROOF SURVEY UNDER

Application No. 64180 Permit No. 47136
IN NAME OF

LANCE S. SZYMANSKI

Surveyed JULY 19, 1984, by D. CLARK