


T. 26 S., R. 3 W., W.M.

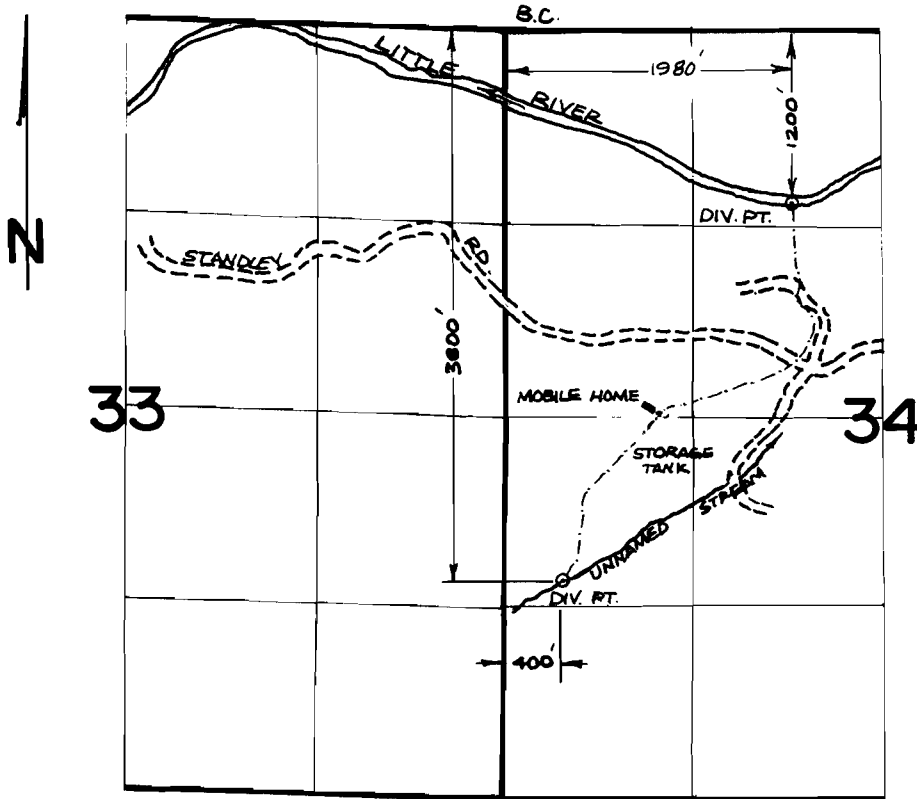

SCALE : 4" = 1 MILE

FINAL PROOF SURVEY UNDER

Application No. 63792 65983 Permit No. 47260 48035
IN NAME OF

MICHAEL G. WALTERS

Surveyed FEB. 5, 12, 19.88, by J.M. SCHMORDE...