


T. 48 & 5 S., R. 1 W., W. M.

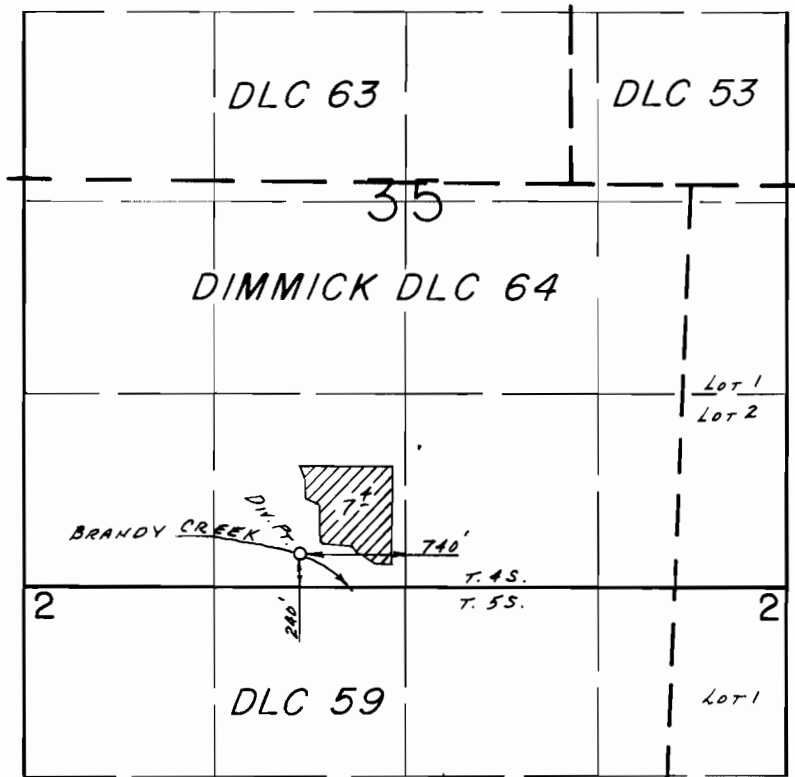

SCALE: 1" = 1320'

**FINAL PROOF SURVEY**  
UNDER

Application No. 65223. Permit No. 47658.....  
IN NAME OF

.....RAYMOND M. MONNIER.....

Surveyed April 26 1988, by Z. SALEH.....