


T.2S. R.38E., W.M.

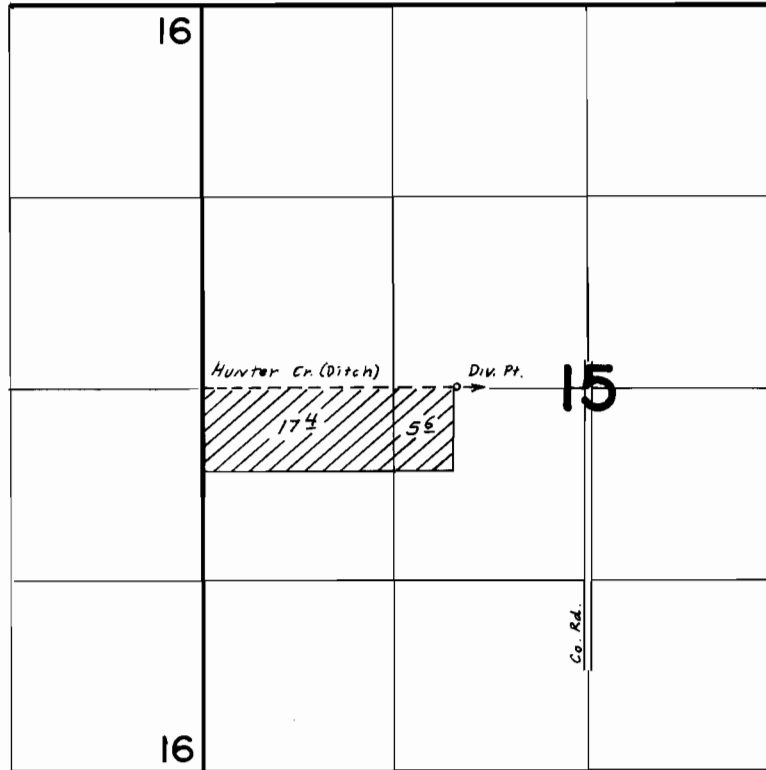

Div. Pt. Loc. 10' N. & 1750' E. From W. 1/4 Cor. Sec. 15

FINAL PROOF SURVEY
UNDER

Application No. 57196..... Permit No. 43048.....
IN NAME OF

BERT M. MARX & SHERRIE D. WILHELM

Surveyed AUG. 23. 1979., by CHURCH-JARRETT