


# T. 22 S., R. 6 W., W. M. SECTION 13

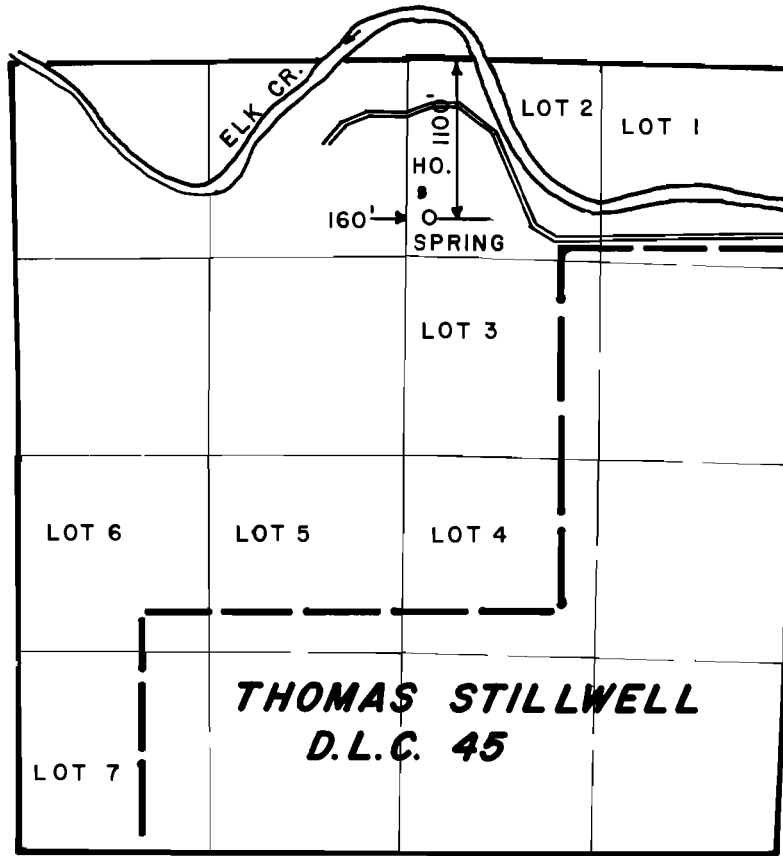

SCALE : 4" = 1 MILE

## FINAL PROOF SURVEY UNDER

Application No. 61004..... Permit No. 45483.....  
IN NAME OF

**LEROY PALMER**

Surveyed AUG. 4..... 1988., by J.M. SCHMORDE