


T.T.15 S. R. 5W. W.M.

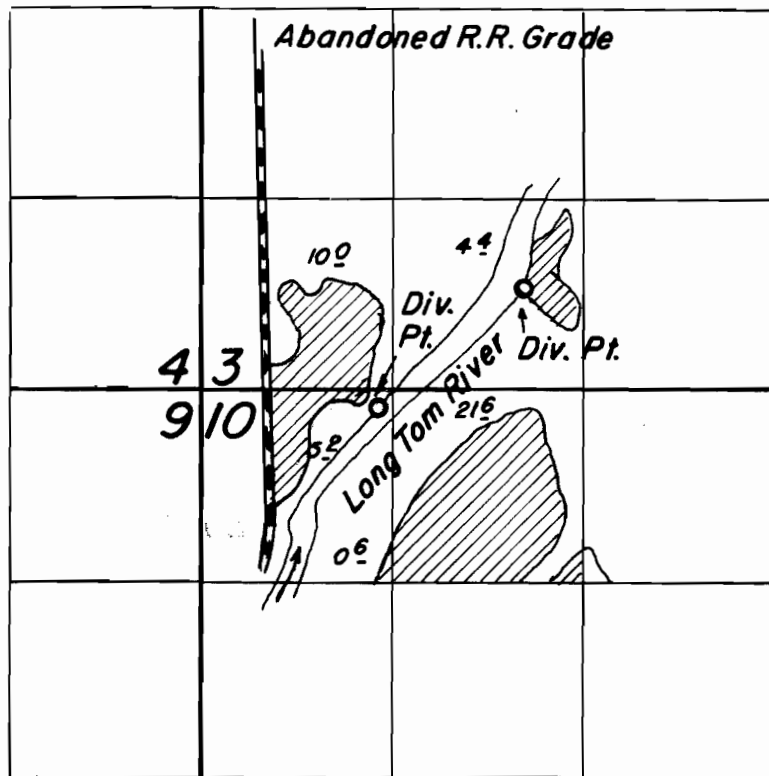

FINAL PROOF SURVEY
UNDER

Application No. 32757 Permit No. 25853
IN NAME OF

Dennis & Jennie M. Stroda

Surveyed May 22 1963, by Floyd L. Siegmund