


# T.8S.R.6W.W.M.

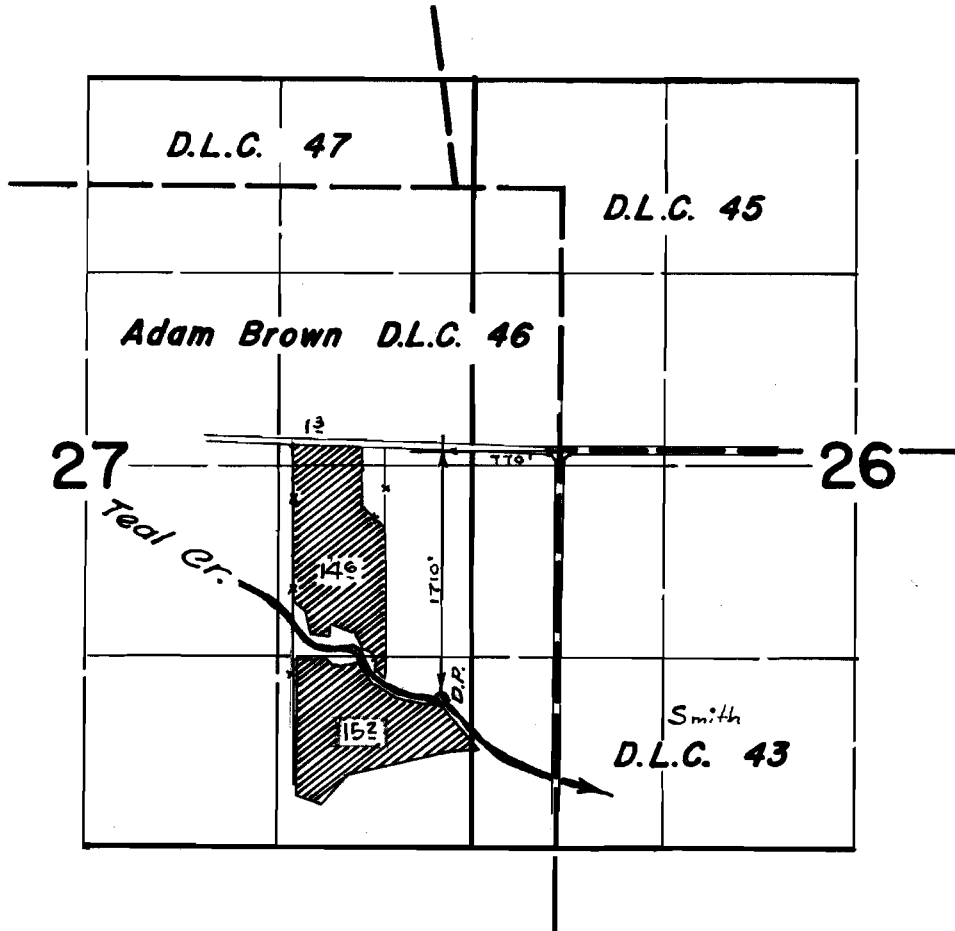

## FINAL PROOF SURVEY UNDER

Application No. 40701... Permit No. 30319  
IN NAME OF

ROSS R. MURPHY

Surveyed July 27, 1966, by *R. Jackson*