


T. 7S., R. 3W., W.M.

SEC. 25

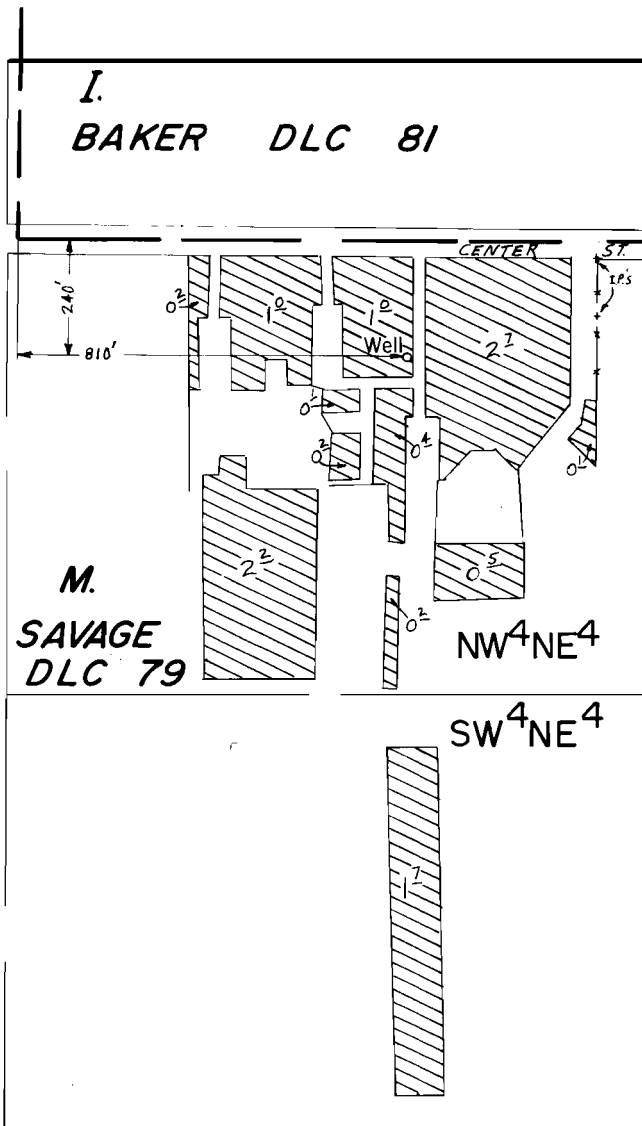

Scale : 1" = 400'

FINAL PROOF SURVEY UNDER

Application No. G-7282... Permit No. G-6712.....
IN NAME OF

MARION COUNTY

Surveyed April 14, 1986., by T. Warren.....