




T.24 S., R.13 W., W.M.

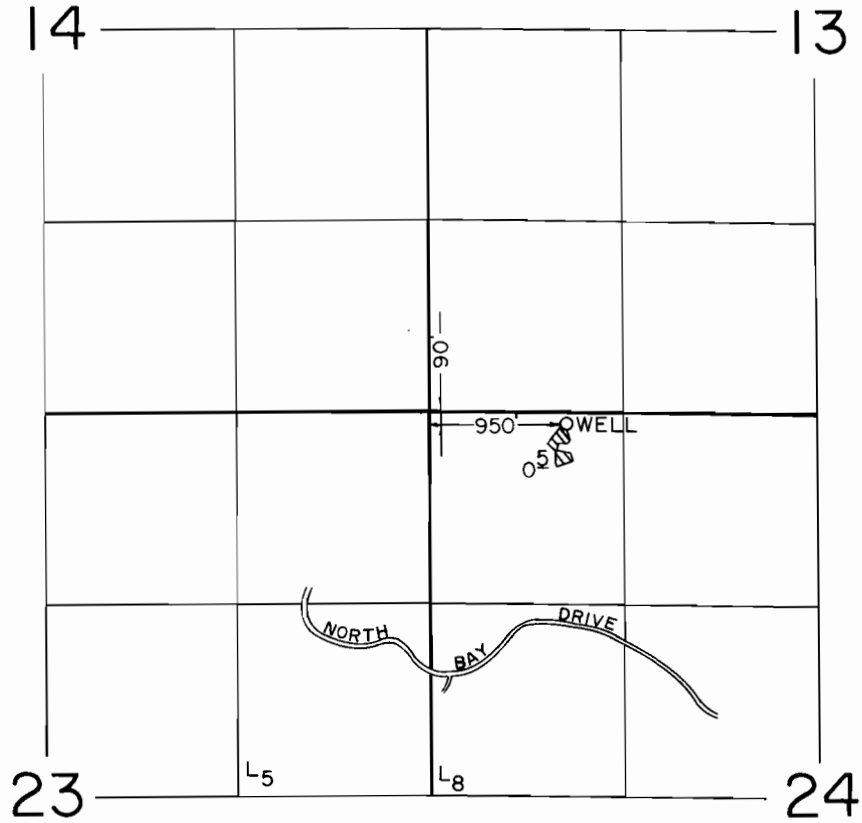

SCALE: 1" = 1320'

**FINAL PROOF SURVEY**  
UNDER

Application No. G-9306. Permit No. G-8787.....  
IN NAME OF

LOWELL D. & BETTY J. NIELSON

Surveyed SEPT. 20, 1988., by V. L. CHURCH.....