


T.14 S., R. 4 W., W. M.

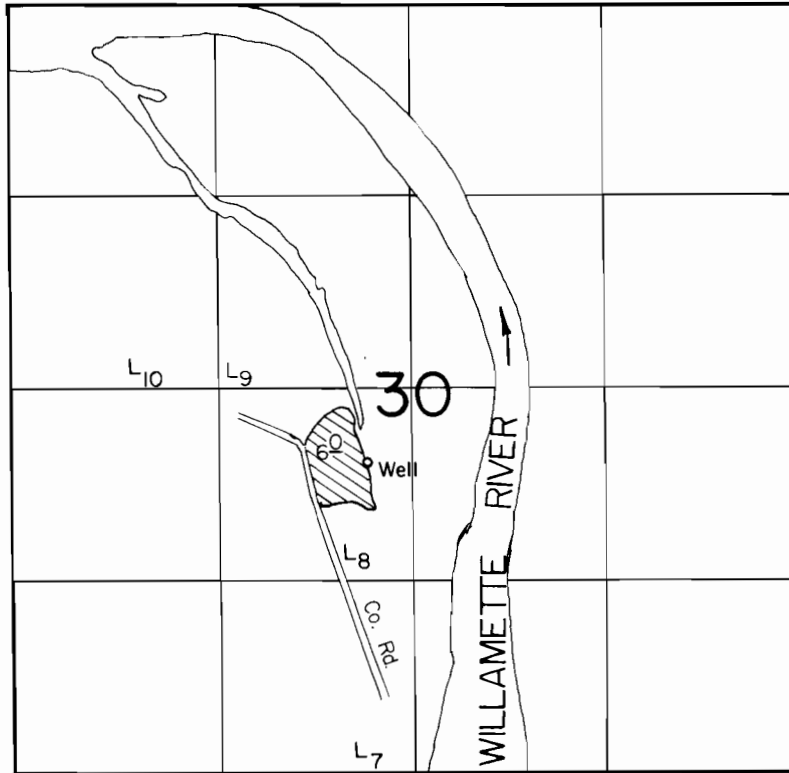

Well Loc. : 500' S. & 2440' E. from W. 1/4 Cor. Sec. 30.

Scale : 1" = 1320'

**FINAL PROOF SURVEY**  
UNDER

Application No. G-9600. Permit No. G-9317.....  
IN NAME OF

**PAUL ESTERGAARD**

Surveyed Dec. 1, 1987., by J. Warren.....