


T1&2N, R14E, WM

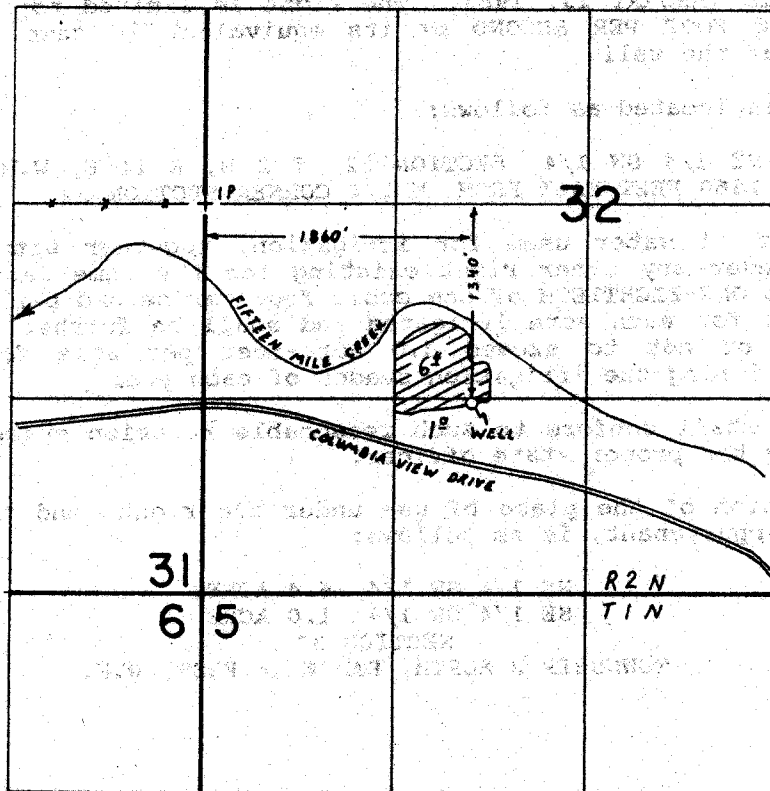

SCALE:
1" = 1320'

FINAL PROOF SURVEY UNDER

Application No. G-10868 Permit No. G-10012..
IN NAME OF

ROSEMARY SHANKS

Surveyed APRIL 13 1988, by T. M. WARREN