


TIIS, RIW, WM

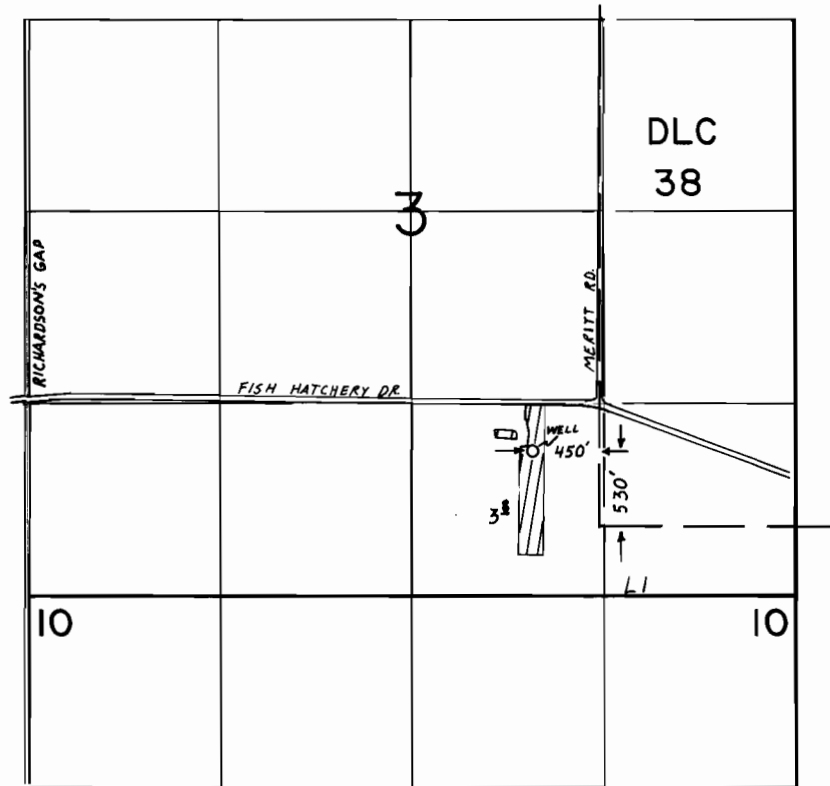

FINAL PROOF SURVEY UNDER

Application No. G-10915.. Permit No. G-10136....
IN NAME OF

.....GRAHAM ROWBOTTOM.....

Surveyed SEPT. 9. 1988, by T. M. WARREN...